2024-17444

RECORDED: 07/17/2024 01:27:09 PM

RECORDING FEE: \$7.00 IOWA E-FILING FEE: \$3.00 COMBINED FEE: \$10.00 REVENUE TAX: \$0.00

SANDIE L. SMITH, RECORDER BLACK HAWK COUNTY, IOWA

Prepared by & Return to: Isaiah M. Reicks, HRS, LLC, 2206 East Bremer Avenue, Waverly, IA 50677, Phone 319-483-5187

United States Public Land Survey Corner Certificate

Land Survey Monument situated in

Section **35**, Township **90** North, Range **13** West of the Fifth Principal Meridian, **Black Hawk** County, Iowa. On file in **Book 331**, **Page 708** in the County Recorder's Office.

This certificate is being prepared in compliance with Iowa Code Chapter 355.11 because:

☐ There is no certificate on file for this corner.
 ☐ There are no longer three valid ties of record.
 ☐ There are changes to reference ties of record.
 ☒ There is change of monumentation of record.
 ☐ To clarify description of record monument (ties).

Monument Description and Remarks:

North 1/4 Corner:


Found 5/8"Ø Rebar with information obtained from the previously recorded Section Corner Certificate.


Set 1"Ø Bronze Survey Marker PLS 22468 with coordinates of the found location obtained prior to highway reconstruction.

Corner reset in conjunction with Project No. FM-C007-(171)--55-07.

Plan View - Not to Scale

(Show a minimum of three reference ties to durable physical objects, relevant monuments and physical conditions that will enable recovery of the corner.)

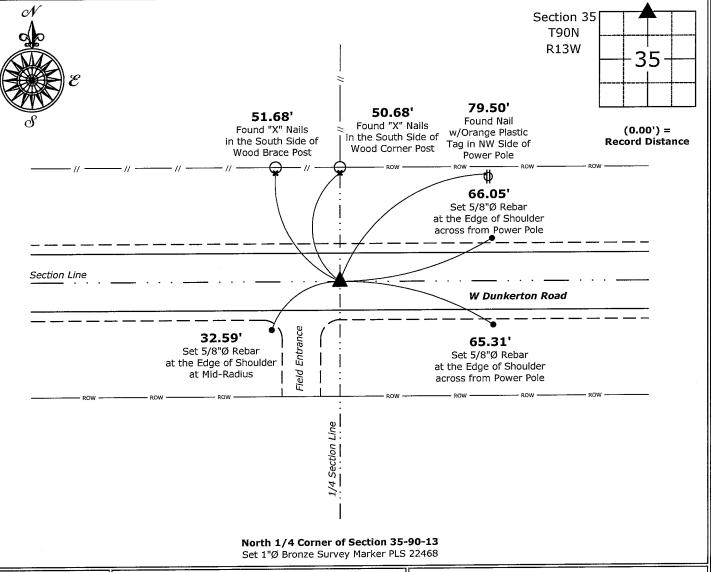

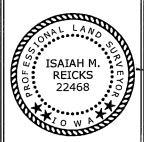

I hereby certify that this land surveying document was prepared and the related survey work was performed by me or under my direct personal supervision and that I am a duly licensed Land Surveyor under the laws of the State of Iowa.

Isaiah M. Reicks Date:

License number 22468

My license renewal date is December 31, 2025. Sheets covered by this seal: Individual sheet only

LISE CORNER to be indexed			
Corner	Section	Township	Range
N 1/4	35	90	13

Project Number: 2024-549 FB: Black Hawk 12, Page(s) 17, 21 ile: I:_Projects - WO\County Control Systems_WO\BLACK HAWK\BHCO-7\BHCO-7\BHCO-7-2024.dwg, 7/15/2024 3:52:56 PM