

PREPARED BY / RETURN TO: MIRANDA K. EILDERS IOWA DEPARTMENT OF TRANSPORTATION 428 43rd ST. SW MASON CITY, IA 50401 641-423-7584

UNITED STATES PUBLIC LAND SURVEY CORNER CERTIFICATE  
OF

Land Survey Monuments situated in Section 36, Township 90N, Range 13W  
of the Fifth Principal Meridian, BLACK HAWK County, Iowa.

Previously recorded in \_\_\_\_\_ in County Recorder's Office.  
(book, page, document number, etc.)


(Show reason for preparing this certificate, the evidence and detailed procedures used in establishing the corner positions and monumentation found or placed.)

Monument Description and Remarks: NW CORNER: REPLACED PREVIOUSLY FOUND IDOT ALUMINUM DISC  
WITH A MAG SPIKE/IDOT SEC. COR. WASHER \*22293 NEAR C OF SOUTH BOUND LANE OF US 63 PER IDOT  
INFORMATION OF RECORD AFTER RESURFACING PROJECT NHSN-063-(93)--2R-07.  
REASON FOR CERT: MONUMENTATION AND TIES HAVE CHANGED.

W 1/4 CORNER: REPLACED PREVIOUSLY FOUND IDOT ALUMINUM DISC WITH A MAG SPIKE/IDOT SEC. COR. WASHER  
\*22293 4.5' EAST OF C OF NORTH BOUND LANE OF US 63 PER IDOT INFORMATION OF RECORD  
AFTER RESURFACING PROJECT NHSN 063-(93)--2R-07.  
REASON FOR CERT: MONUMENTATION AND TIES HAVE CHANGED.

PLAN - VIEW

(Show a minimum of three reference ties to durable physical objects, relevant monuments and physical conditions that will enable recovery of the corner.)

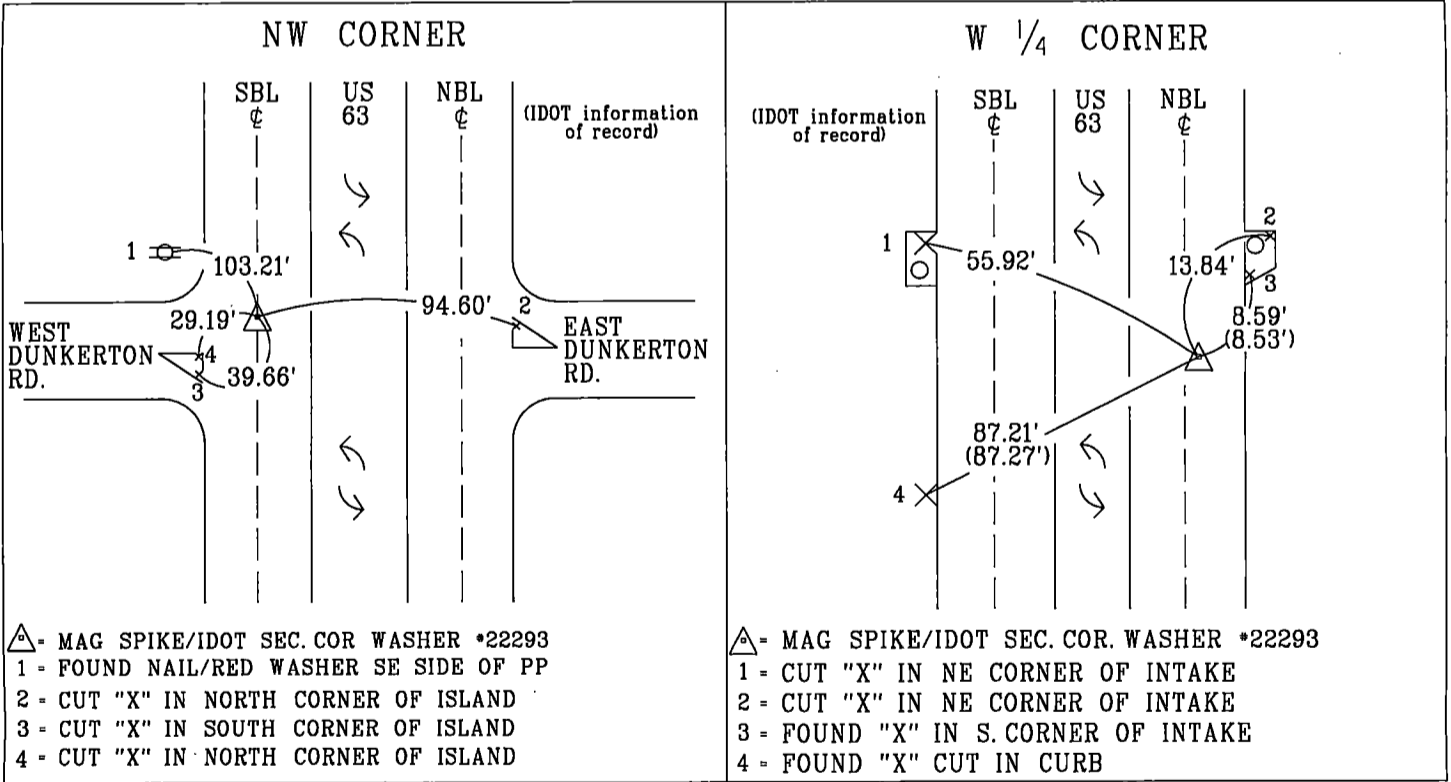

MIRANDA K. EILDERS  
22293  
IOWA

I hereby certify that this land surveying document was prepared and the related survey work was performed by me or under my personal supervision and that I am duly licensed professional Land Surveyor under the laws of the state of Iowa.

Miranda K. Eilders 5-24-2020  
Miranda K. Eilders Date  
License number 22293  
My License renewal date is December 31, 2021  
Pages or sheets covered by this seal. 1

List Corners to be Indexed			
Corner	Section	Township	Range
NW CORNER	36	90N	13W
W 1/4 CORNER	36	90N	13W

N