

PROOF FILED FOR RECORD APR 16, 2003, AT 3:00 P. M. FEE 1-5.00/

COMPARED

*Patricia A. Busse*

BLACK HAWK COUNTY RECORDER

STEVE BUSSE BOX 241 ALLISON IOWA 50602

STEVE BUSSE P.O. BOX 241 508 ELM STREET ALLISON, IOWA 50602 219-267-2519  
UNITED STATES PUBLIC LAND SURVEY CORNER CERTIFICATE

Land Survey Monuments situated in Section: 32 Township 91 North  
Range: 14 West Of the Fifth Principal Meridian, BREMER County, Iowa.  
Previously recorded in N/A In County Recorder's Office.

Book, page, document number, etc.


(Show reason for preparing this certificate, the evidence and detailed procedures used in establishing the corner positions and monumentation found or placed.)

Monument Description and Remarks:

Found 5/8" rebar at each corner. At  
South 1/4 COR. found rebar 12.4' west of North-South fence in  
center of road. At SW COR. Found 5/8" rebar in center of  
intersection and 33' from right of way fences. Each rebar  
had a nail with ribbon beside rebar.

## PLAN - VIEW

(Show a minimum of three reference ties to durable physical objects, relevant monuments and physical conditions that will enable recovery of the corner)

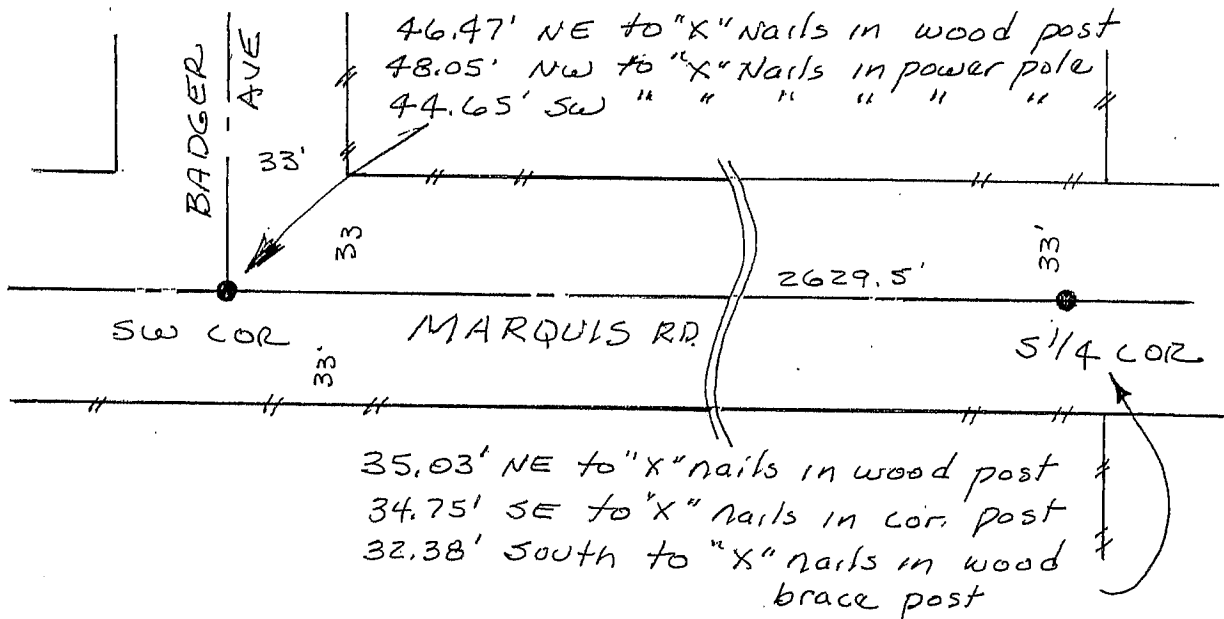

I hereby certify that the survey work was completed and this land surveying document was prepared by me or under my direct personal supervision and that I am a duly licensed land surveyor under the laws of the state of Iowa.

Signature: *Steve Busse*  
Name typed or printed: STEVE BUSSE

Date: 4/16/03 Reg. No. 9018

My license renewal date is December 31, 2004

SEAL

| Corners   | List Corners to be Indexed |     |       |
|-----------|----------------------------|-----|-------|
|           | Section                    | Twp | Range |
| SW COR    | 32                         | 91  | 14    |
| S 1/4 COR | 32                         | 91  | 14    |
| N 1/4 COR | 5                          | 90  | 14    |
| NW COR    | 5                          | 90  | 14    |