


Kind: CORNER
Recorded: 12/05/2012 at 01:41:41 PM
Fee Amt: \$0.00 Page 1 of 1
Black Hawk County Iowa
JUDITH A MCCARTHY RECORDER

File 2013-00011521

PREPARED BY: \*BLACK HAWK COUNTY ENGINEERS OFFICE PH.# (319) 833-3008 FAX.# (319) 833-3139 SLSI 9-94 BHCO 03-09 316 E. FIFTH STREET, ROOM 211 WATERLOO, IOWA 50703 UNITED STATES PUBLIC LAND SURVEY CORNER CERTIFICATE OF Land Survey Monuments situated in Section\_\_\_ 6 \_\_ , Township<u>90 N</u>\_ Range 90 W , of the Fifth Principal Meridian, BLACK HAWK County, Iowa. Previously recorded in Fee Book 2003, Page 20199, in County Recorder's Office. (Show reason for preparing this certificate): The corner monument has been Replaced or Modified, per Ia. Code 355.11(1)(c) (Evidence and detailed procedures used in establishing the corner position(s) and monumentation found or placed.) Monument Description and Remarks: **CENTER**! CORNER RESET & TIÈS UPDATED PER H.M.A. RESURF, PROJECT LFM-503-<u>--7X-07,</u> RESURF. PROJECT, CURRENT RECORD PK & ALUM. WASHER WERE NOT FOUND @ CORNER LOCATION. CALCULATED CORNER LOCATION ON LINE BETWEEN N/S 1/4 CORNERS PER 1982
PLAT OF SURVEY IN MISC. BK. 246 p.242, AND LOCATED ±2431' SOUTH OF N. 1/4 CORNER
PER RECORD BH. COUNTY PROJECT PLANS (PROPORTIONED TRANSIT NOTES). CORNER LOCATION ±0.5' NORTH OF INTERSECTING TWO EXISTING FOUND TIES WESTERLY OF CORNER, WITH NO R.O.W. CORNER TO WEST FOUND. AFTER 1.5" DEEP MILL & REFILL W/INTERMED. COURSE H.M.A., NO SOUNDING REMAINING @ LOCATION. AFTER ADDITIONAL 1.5" H.M.A. SURFACE COURSE, RESET CORNER WITH 5/8" (#5) x ±8"L REBAR LOCATED @ C.L. H.M.A. JOINT. BHco Hist. Ties: TRANSIT NOTES PLAN VIEW FIELD BOOK: Ties per Topcon 7003i #Z0115 "NOT TO SCALE" (Show a minimum of three reference ties to durable physical objects, relevant monuments and physical conditions that will enable recovery of the corner.) TIES PER EDM MEASURE IN EITHER PRISM "OR" NON-PRISM MODE, WHILE UTILIZING "INDIRECT" MEASURE, WITH ALL DISTANCES PLUMB/HORIZ. (HD), UNLESS DENOTED. 1.) N. 1/4 COR. SECT. 6-T90-R14 (per Updated Cert.) 8 SECTION LINE MEASURE REFERS TO "LOCAL GROUND" DIST. AND INCLUDES ELLIPSOID (COMBINED) SCALE FACTOR FROM S.P.C. GRID INVERSE (AS DBSERVED), PER AVG. SCALE FACTOR = 1.000093804492. R 14 W UTIL. FND "X" NAILS @ S.E. FACE P.P. @ ±6.3' HT. SET #5 x ±30" L. RBR. @ ± TOP BACKSLOPE FLUSH w/ GROUND w/ T-POST @ ' GROUND w/ T-PI .5' EAST OF RBR. \_AC. CROPS ,6<sup>4</sup> TINCHFORD 180°00' (M. & P.) \_AG. CRIPS-SET #5 x ±30" L. RBR. @ ± TOP BACKSLOPE FLUSH w/ GROUND w/ T-POST @ ±0.5" EAST OF RBR. \_AG. CROPS- $\mathbb{Z}$ م 2646,99' F WPA N/A) UTIL. FND "X" NAILS @ N.E. FACE P.P. @ ±6.4' HT. 2647,91′ (P.) = per Plat of Survey FEE Bk. 2003-20198 S.P.C., la. N. Zone, USft N = 3696130.80بة خ چ 1/4 COR. E = 5178535.09SECT. 7-T90-R14 (per Updated Cert.) CONVERGENCE = 0° 38' 53" FIELD SURVEY: S.S. (NAD83-NSRS2007 "BHco07", RTK Obs.) 9/11/12 PREPARED BY: S.S. & G.T. 12/4/12 <u>CERTIFICATION</u>

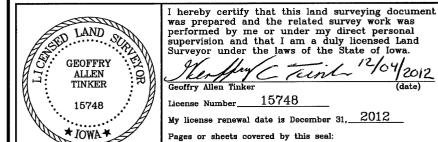

This Land Corner Certificate Only.

LIST	CORNERS TO	BE INDEXED	
<u>Corner</u>	<u>Section</u> -	<u>Township</u> –	<u>Range</u>
CENTER	6	90 N	14 W

## INDEX OF ABBREVIATIONS

"Measured" Dimension "NP" = Reflectorless EDM !

"Platted" Dimension "MLM" = Indirect Measure

"Record" Dimension "CM" = Concrete Monumen

"Calculated" Dimension "SM" = Survey Marker Spil

I work Geodetic Survey "PK" = PK/MAG Nail Brand

per George Miller Survey (BHco Surveyor 1858-1860)

per John Ball Survey (BHco Surveyor 1908-1931)

per Nathan Barber Survey (BHco Surveyor 1908-1931) "NP" = Reflectorless EDM Meas.
"MLM" = Indirect Measure
"CM" = Concrete Monument
"SM" = Survey Marker Spike/Tag
"PK" = PK/MAG Nail Brand Style

l