

UNITED STATES PUBLIC LAND SURVEY CORNER CERTIFICATE

OF

Land Survey Monuments situated in Section 6, Township 90N, Range 14W of the Fifth Principal Meridian, Black Hawk County, Iowa. Previously recorded in _____ in County Recorder's Office.





(Book, page, document number, etc.)

(Show reasons for preparing this certificate, the evidence and detailed procedures used in establishing the corner positions and monument found or placed.)

Monument Description and Remarks: Found 7/8 Iron Pipe for W 1/4 cor.
Found 2" pipe for S.W. cor.

PLAN - VIEW


(Show a minimum of three reference ties to durable physical objects, relevant monuments and physical conditions that will enable recovery of the corner.)

 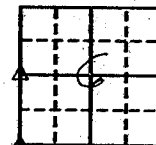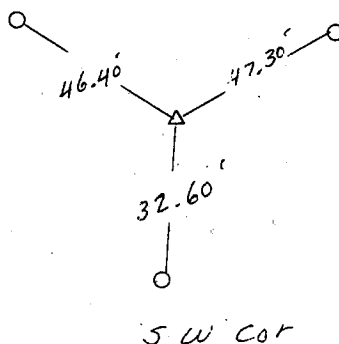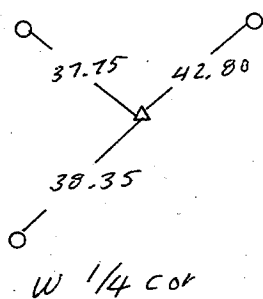

I hereby certify that the survey work was completed and this land surveying document was prepared by me or under my direct personal supervision and that I am a duly registered land surveyor under the laws of the state of Iowa

Signature: Robert L. HaylockName typed or printed: Robert L. HaylockDate: 6-1-96 Reg. No. 5680My registration renewal date is December 31, 1996

SEAL

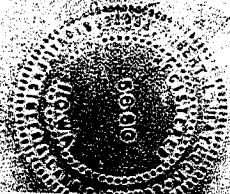

Corners	List Section	Corners to be Indexed Twp	Range
W 1/4	6	90	14
S.W. cor	6	90	14