

Misc =  
INDEX *cf*  
MARGIN  
PROOF  
COMPARE

County Assessor

BLACK HAWK COUNTY IOWA: SS 18798  
Filed for record APR 11, 1997 at  
4:00 P.M. and recorded in Book 324  
of Misc Page 771.  
*Patricia L. Less* Recorder  
Fee N/C  
COUNTY ENGINEER

PREPARED BY: BLACK HAWK COUNTY ENGINEERS OFFICE PH.# (319) 291-2419 SLSI 9-94  
316 E. FIFTH STREET, ROOM 211 WATERLOO, IOWA 50703 FAX.# (319) 291-2461 CERT 12-96


UNITED STATES PUBLIC LAND SURVEY CORNER CERTIFICATE OF  
Land Survey Monuments situated in Section 7, Township 90 N,  
Range 14 W, of the Fifth Principal Meridian, BLACK HAWK County, Iowa.  
Previously recorded in Book N/A, Page N/A, in County Recorder's Office.

(Show reason for preparing this certificate, the evidence and detailed procedures used in establishing the corner positions and monumentation found or placed.)


Monument Description and Remarks: Found 5/8" Rebar flush w/ A.C.C. surf.  
loc. @ centerline Int. of County Roads T71 & C55. Field recovered two sets of  
"X" nails previously utilized and documented in County Engineers Corner Tie Book  
#1003 (red dot bk.) dated 5/83 along with a prior ref.'ed U.S.G.S. monument.  
Found ties agree (+/-) & Est. two additional ref. ties due to found positions.  
Corner utilized for Plat of Survey, County Shop Parcel in NE 1/4, NW 1/4.

### PLAN - VIEW

(Show a minimum of three reference ties to durable physical objects, relevant monuments and physical conditions that will enable recovery of the corner.)

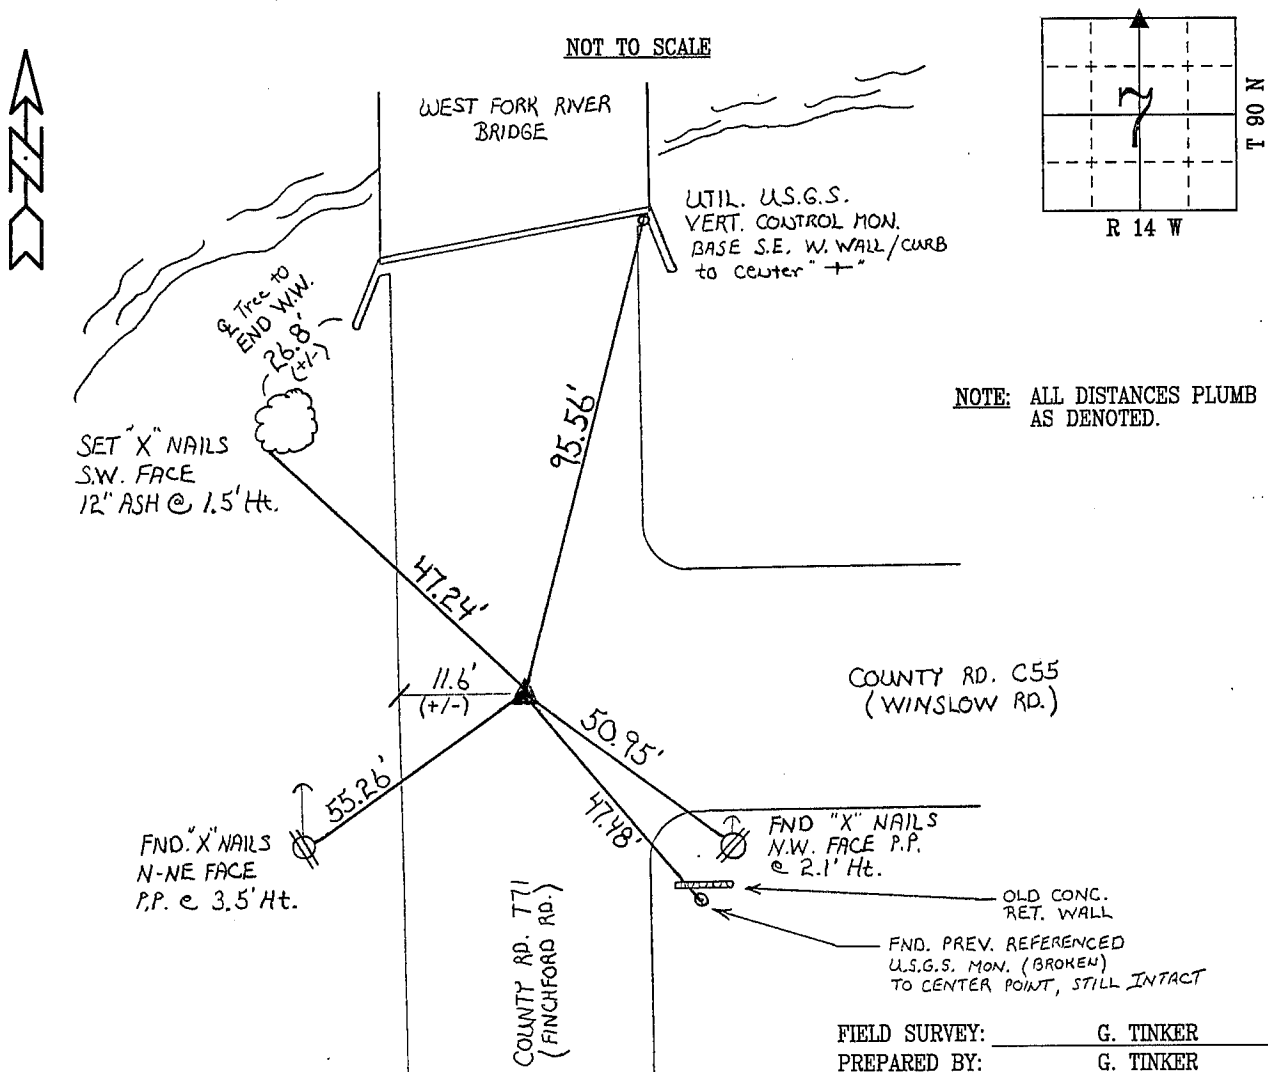

### CERTIFICATION

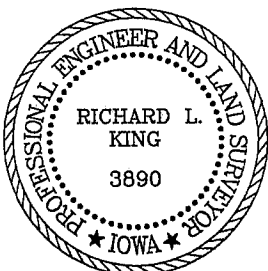

I hereby certify that this land surveying document was prepared and the related survey work was performed by me or under my direct personal supervision and that I am a duly licensed Land Surveyor under the laws of the State of Iowa.

*Richard L. King* 4/11/97  
Richard L. King (date)

License Number 3890

My license renewal date is December 31, 1997

Pages or sheets covered by this seal:

This Land Corner Certificate Only.

### LIST CORNERS TO BE INDEXED

Corner	Section	Township	Range
N 1/4	7	90 N	14 W

BOOK 324 PAGE 771