

Doc ID: 004991520001 Type: GEN
Kind: CORNER
Recorded: 12/05/2012 at 01:41:53 PM
Fee Amt: \$0.00 Page 1 of 1
Black Hawk County Iowa
JUDITH A MCCARTHY RECORDER

File 2013-00011522

PREPARED BY: *BLACK HAWK COUNTY ENGINEERS OFFICE 316 E. FIFTH STREET, ROOM 211 WATE

WATERLOO, IOWA 50703

PH.# (319) 833-3008 FAX.# (319) 833-3139

SLSI 9-94 BHCO 03-09

UNITED STATES PUBLIC LAND SURVEY CORNER CERTIFICATE OF

Land Survey Monuments situated in Section____ <u>7</u>, Township <u>90 N</u>

Range 14 W , of the Fifth Principal Meridian, BLACK HAWK County, Iowa. Previously recorded in Misc Book 324, Page 771, in County Recorder's Office.

(Show reason for preparing this certificate): The corner monument has been Replaced or Modified, per Ia. Code 355.11(1)(c)

(Evidence and detailed procedures used in establishing the corner position(s) and monumentation found or placed.)


Monument Description and Remarks: N. 1/4 CORNER CORNER RESET & TIES UPDATED PER H.M.A. RESURF. PROJECT

LFM-503--7X-07. PRIOR TO RESURF, PROJECT, FOUND 5/8" (#5) REBAR PER CURRENT RECORD AND TEMP. REF.

COR. LOCATION PER RTK GPS. AFTER 1,5" DEEP MILL & REFILL W/INTERMED. COURSE H.M.A.,

NO SOUNDING REMAINING @ LOCATION. AFTER ADDITIONAL 1,5" H.M.A. SURFACE COURSE,

RESET CORNER WITH 5/8" (#5) x ±8"L REBAR LOCATED @ ±0.5" EAST OF H.M.A. JOINT AND ALIGNED ±0.7' SOUTH OF H.M.A. JOINT TO EAST.

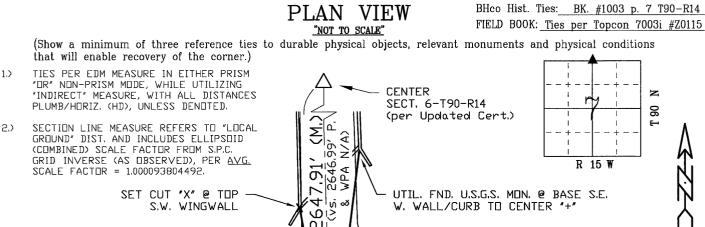



FINCHFORD (H.M.A.)

٥

(P.) = To C.N. 16th Corner per Plat of Survey File #2010-00011126 Also refer to ADDITIONAL Record Meas, per Survey in File 2013-00000118

> 55.24' -(55,25' BHco R.) (55,26' R.)

178°52′53″(M.)

UTIL. FND. "X" NAILS @ N.-N.E. FACE P.P. @ ±3.5' HT.

S.P.C., la. N. Zone, USft

N = 3693484.11E = 5178606.77

CONVERGENCE = 0° 38' 53"

(NAD83-NSRS2007 "BHco07", RTK OBs.)

(P.) = To Center Sect. #6 per Plat of Survey Fee Bk. #2003-20198 à **5.40** BHG SG' R'S (95,60/ 51.00 WINSLOW RD. (50.92' BHco R.) (50.95' R.) (H.M.A.) 47.51 (47.48' R.) - UTIL, FND. "X" NAILS @ N.W. FACE P.P. @ ±2.1' HT. - OLD CONCRETE WALL

UTIL. FND. U.S.G.S. MON. TO CENTER POINT (BROKEN)

C.N. 16th CORNER SECT. 7-T90-R14 (per Updated Cert.)

FIELD SURVEY:

9/11/12 S.S.

PREPARED BY: S.S. & G.T. 12/5/12

GEOFFRY ALLEN TINKER 15748

*AWO! *

I hereby certify that this land surveying document was prepared and the related survey work was performed by me or under my direct personal supervision and that I am a duly licensed Land Surveyor under the laws of the State of Iowa. 12/05 5/2012 (date)

Tinker

15748

<u>CERTIFICATION</u>

My license renewal date is December 31, 2012

Pages or sheets covered by this seal:

This Land Corner Certificate Only

LIST	CORNERS TO	BE INDEXED	
Corner	<u>Section</u> -	<u>Township</u> –	<u>Range</u>
N. 1/4 Cor.	7	90 N	14 W
S. 1/4 Cor.	6	90 N	14 W

INDEX OF ABBREVIATIONS

(M) = (P) = (R) = (C) = "IGS" "WPA" """ "Measured" Dimension
"Platted" Dimension
"Record" Dimension
"Calculated" Dimension

"NP" = Reflectorless EDM Meas.
"MLM" = Indirect Measure
"CM" = Concrete Monument
"SM" = Survey Marker Spike/Tag
"PK" = PK/MAG Nail Brand Style