

Doc ID: 004217470001 Type: GEN Kind: CORNER Kind: CORNER Recorded: 08/04/2010 at 10:12:30 AM Fee Amt: \$0.00 Page 1 of 1 Black Hawk County Iowa JUDITH A MCCARTHY RECORDER

File 2011-00002252

PREPARED BY:

BLACK HAWK COUNTY ENGINEERS OFFICE

WATERLOO, IOWA 50703 316 E. FIFTH STREET, ROOM 211

PH.# (319) 833-3008 FAX.# (319) 833-3139

UNITED STATES PUBLIC LAND SURVEY CORNER CERTIFICATE OF


Land Survey Monuments situated in Section 8 __ , Township<u> 90 N </u>

Range 14 W, of the Fifth Principal Meridian, BLACK HAWK County, Iowa. Previously recorded in Misc. Book 343, Page 561-562, in County Recorder's Office.

(Show reason for preparing this certificate): The corner monument has been Replaced or Modified, per Ia. Code 355.11(1)(c)

(Evidence and detailed procedures used in establishing the corner position(s) and monumentation found or placed.)

Monument Description and Remarks: N. 1/4 CDR. FOUND #6 (3/4") REBAR IN C.L. OF EXISTING A.C.C. PAVING PRIOR TO RESURF. TEMP. REF. w/RTK GPS, AND MILLED 2" EXIST. ACC PAVEMENT PRIOR TO RESURF. & ADDED 2.5" HMA SURFACE COURSE. REMAINING SOUNDING TO W. OF LOC. (APPEARS PREV. REBAR BENT FROM MILLING & NOT PULLED). CORNER **RESET** WITH 5"L. \times #5 REBAR FLUSH w/HMA PAVEMENT LOC. ±0.10' S. OF C.L. HMA PAVEMENT JOINT.

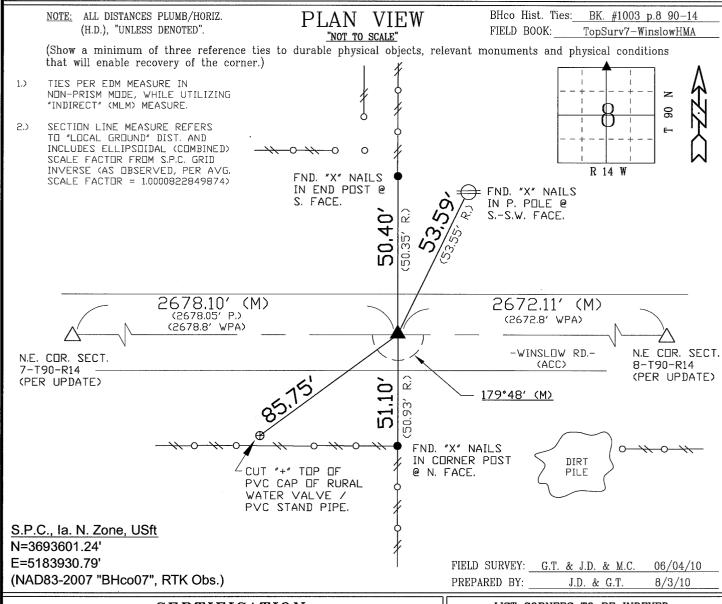

<u>CERTIFICATION</u>



I hereby certify that this land surveying document was prepared and the related surveying documents was prepared and the related survey work was performed by me or under my direct personal supervision and that I am a duly licensed Land Surveyor under the laws of the State of Iowa.

8/03/10

15748 License Number

My license renewal date is December 31, 2010

Pages or sheets covered by this seal:

This Land Corner Certificate Only.

<u>LIST</u>	CORNERS TO	BE INDEXED
Corner	Section -	Township -
N 1/4 Cor	ρ	on N

14 W S. 1/4 Cor. 5 90 N 14 W

INDEX OF ABBREVIATIONS

- = "Measured" Dimension
 = "Platted" Dimension
 = "Record" Dimension
 = "Calculated" Dimension
 = "Calculated" Dimension
 = Iowa Geodetic Survey
 " = Works Progress Admin. Survey
 = per George Miller Survey (BHco Surveyor 1858-1860)
 = per John Ball Survey (BHco Surveyor 1866-1891)
 = per Nathan Barber Survey (BHco Surveyor 1908-1931) "NP" = Reflectorless EDM Meas.
 "MLM" = Indirect Measure
 "CM" = Concrete Monument
 "SM" = Survey Marker Spike/Tag
 "PK" = PK/MAG Nail Brand Style (P) : (R) : (C) : "IGS" "WPA"
- =

<u>Range</u>