

5.00 ✓
Cedar Valley Engineering Co.
2700 Fifth Avenue, NW
Waverly, IA 50677

Recorded

LAND SURVEY MONUMENT RECORD
BLACK HAWK COUNTY, IA

Description of monument and evidence found at corner location.

CONC. MONUMENT - COUNTY RECORD


CONC. MONUMENT - FOUND @ GROUND LEVEL

Sec. 11 , T 90 N , R 14 W
N 1/4 Corner


Location:

☐ Section Corner ☒ Quarter Corner


☐ Corner of _____ Quarter/Quarter

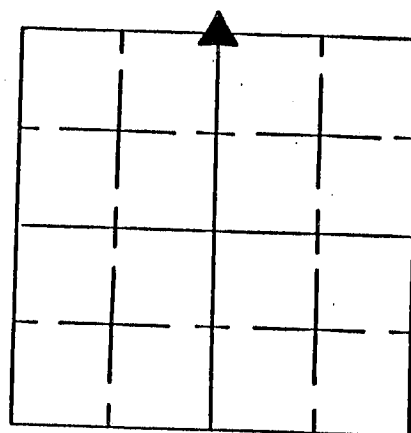

Accessory information found at time of corner location.

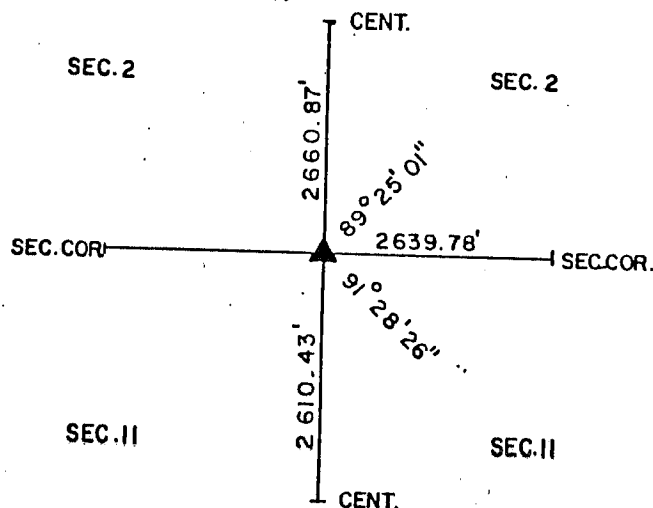


Sketch showing relative location of monument and reference points (minimum of three (3) references).

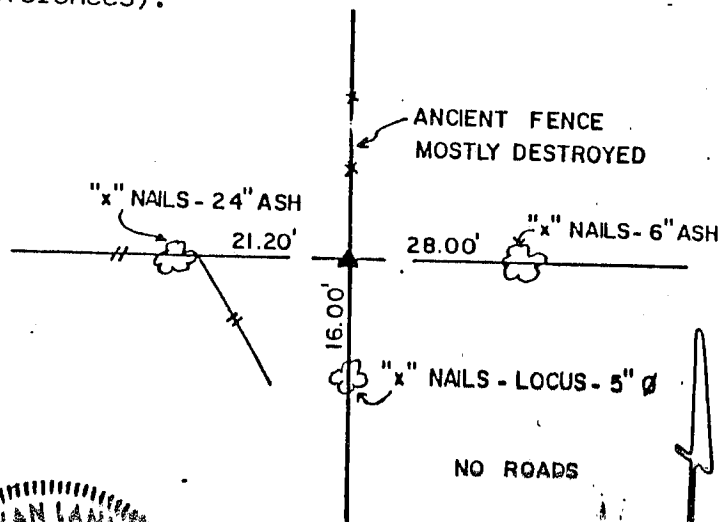

I hereby certify that this plat, map, survey, or report was made by me or under my direct personal supervision and that I am a duly Registered Land Surveyor under the laws of the State of Iowa.

Signed Terry D. Van Laningham Date Oct 10 1990
Terry D. Van Laningham, L.S. Iowa Reg. No. 10793

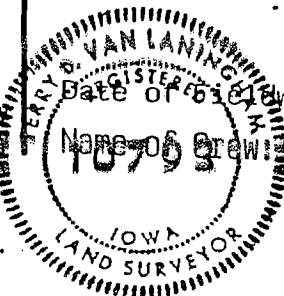

Date of fieldwork: 10/8/1990


EVAN LANINGHAM

A. AKSOY

CEDAR VALLEY ENGINEERING

DRAWN AA

APPROVED

DWG.

293 page 278