

* PREPARED BY / RETURN TO: KENNETH D. STARK IOWA DEPARTMENT OF TRANSPORTATION 1420 4th ST. SE MASON CITY, IA 50401 641-423-7584

UNITED STATES PUBLIC LAND SURVEY CORNER CERTIFICATE
OF

Land Survey Monuments situated in Section 13, Township 90N, Range 14W
of the Fifth Principal Meridian, BLACK HAWK County, Iowa.



Previously recorded in NA in County Recorder's Office.
(book, page, document number, etc.)

(Show reason for preparing this certificate, the evidence and detailed procedures used in establishing the corner positions and monumentation found or placed.)

Monument Description and Remarks: Center found 1" pipe/2½" IDOT aluminum disk using IDOT
information of record. Reason for cert no cert of record and updating IDOT records.

PLAN - VIEW

(Show a minimum of three reference ties to durable physical objects, relevant monuments and physical conditions that will enable recovery of the corner.)

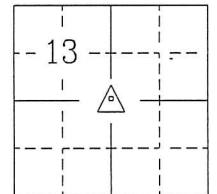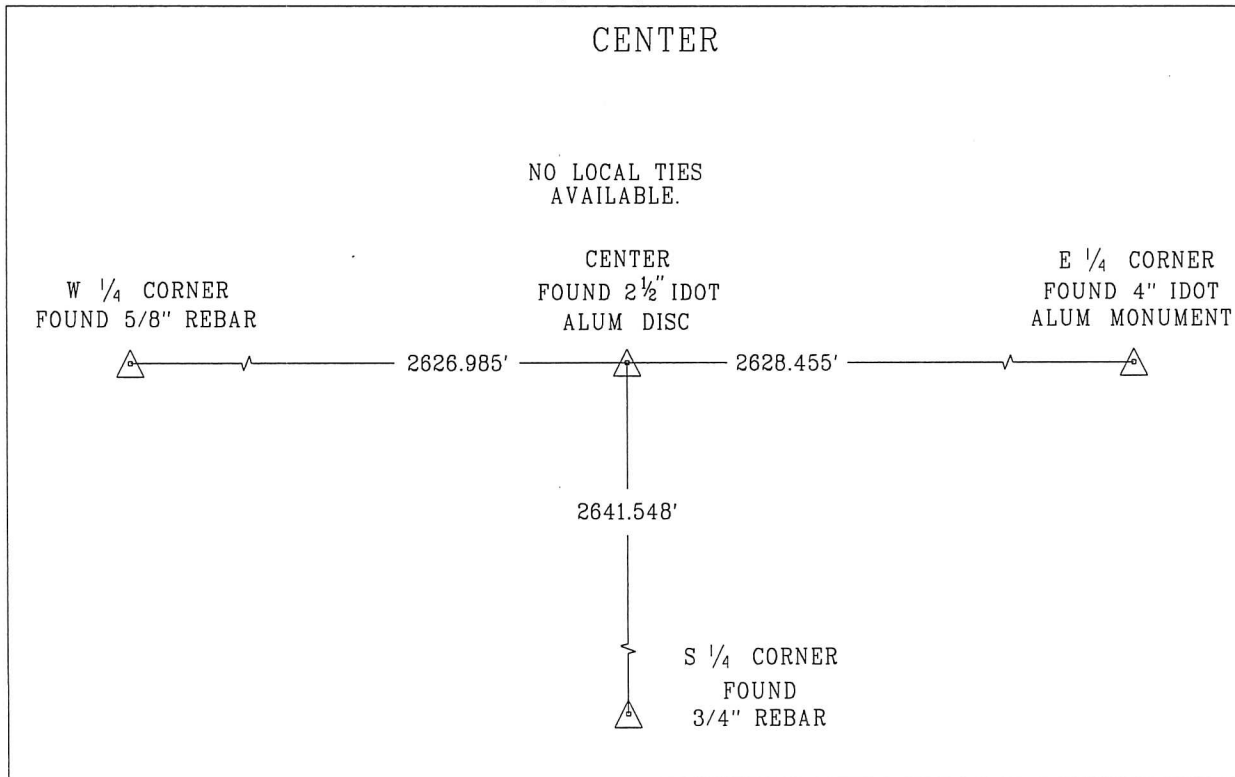

N



I hereby certify that this land surveying document was prepared and the related survey work was performed by me or under my personal supervision and that I am duly licensed Land Surveyor under the laws of the state of Iowa.

Kenneth D. Stark 09-10-15
Kenneth D. Stark Date
License number 10898
My License renewal date is December 31, 2015 /
Pages or sheets covered by this seal. 1

List Corners to be Indexed			
Corner	Section	Township	Range
CENTER	13	90N	14W

drawn by:cls

07-13-90-14

tied by:me,cs
right-of-way

70°2