

* Paul H. Helland, 1107 Technology Parkway, Cedar Falls, Iowa 50613-6951, (319)-266-0161

UNITED STATES PUBLIC LAND SURVEY CORNER CERTIFICATE OF

LAND SURVEY MONUMENTS SITUATED IN SECTION NO. 13, TOWNSHIP NO. 90 NORTH, RANGE
NO. 14 WEST OF THE FIFTH PRINCIPAL MERIDIAN, BLACK HAWK COUNTY, IOWA.
PREVIOUSLY RECORDED IN MISC BK 293 PG 350

(SHOW REASON FOR PREPARING THIS CERTIFICATE, THE EVIDENCE AND DETAILED PROCEDURES USED IN ESTABLISHING THE
CORNER POSITIONS AND MONUMENTATION FOUND OR PLACED.)


MONUMENT DESCRIPTION AND REMARKS:

USPLSCC BK 293 PG 350 MONUMENTATION AND REFERENCE TIES HAVE CHANGED. SURVEY COMPLETED IN THE SE 1/4 OF
SEC. 13-T90N-R14W.

→ **E 1/4 CORNER:** W.P.A. NOTES DATED 8/2/1938 CALLS FOR [DUG AND FOUND NOTHING. ESTABLISHED COR ON THE 1/4
FC. W. AND 2644.2' N. OF THE S.W. COR. SEC. 18 AND 2648.4' S. OF THE N.W. COR. SEC. 18 SET CM 12" DEEP]. USPLSCC
BOOK 293 PAGE 350 DATED 9/25/1990 CALLS FOR [REBAR-FOUND-8" DEEP]. I.D.O.T. ACQUISITION PLAT BK 560 PG 834
DATED 12/16/1991 CALLS FOR [FOUND MON.]. ACQUISITION PLAT IN LD BOOK 569 PAGE 346 DATED 1/10/1997 CALLS FOR
[FOUND 1/2" REBAR]. FOUND 4"Ø ALUMINUM I.D.O.T. MONUMENT (IMPRINTING CORRODED) 1.0' DEEP CORRESPONDING TO
ABOVE REFERENCE DOCUMENTS.

PLAN VIEW


(SHOW A MINIMUM OF THREE REFERENCE TIES TO DURABLE PHYSICAL OBJECTS, RELEVANT MONUMENTS AND PHYSICAL
CONDITIONS THAT WILL ENABLE RECOVERY OF THE CORNER.)

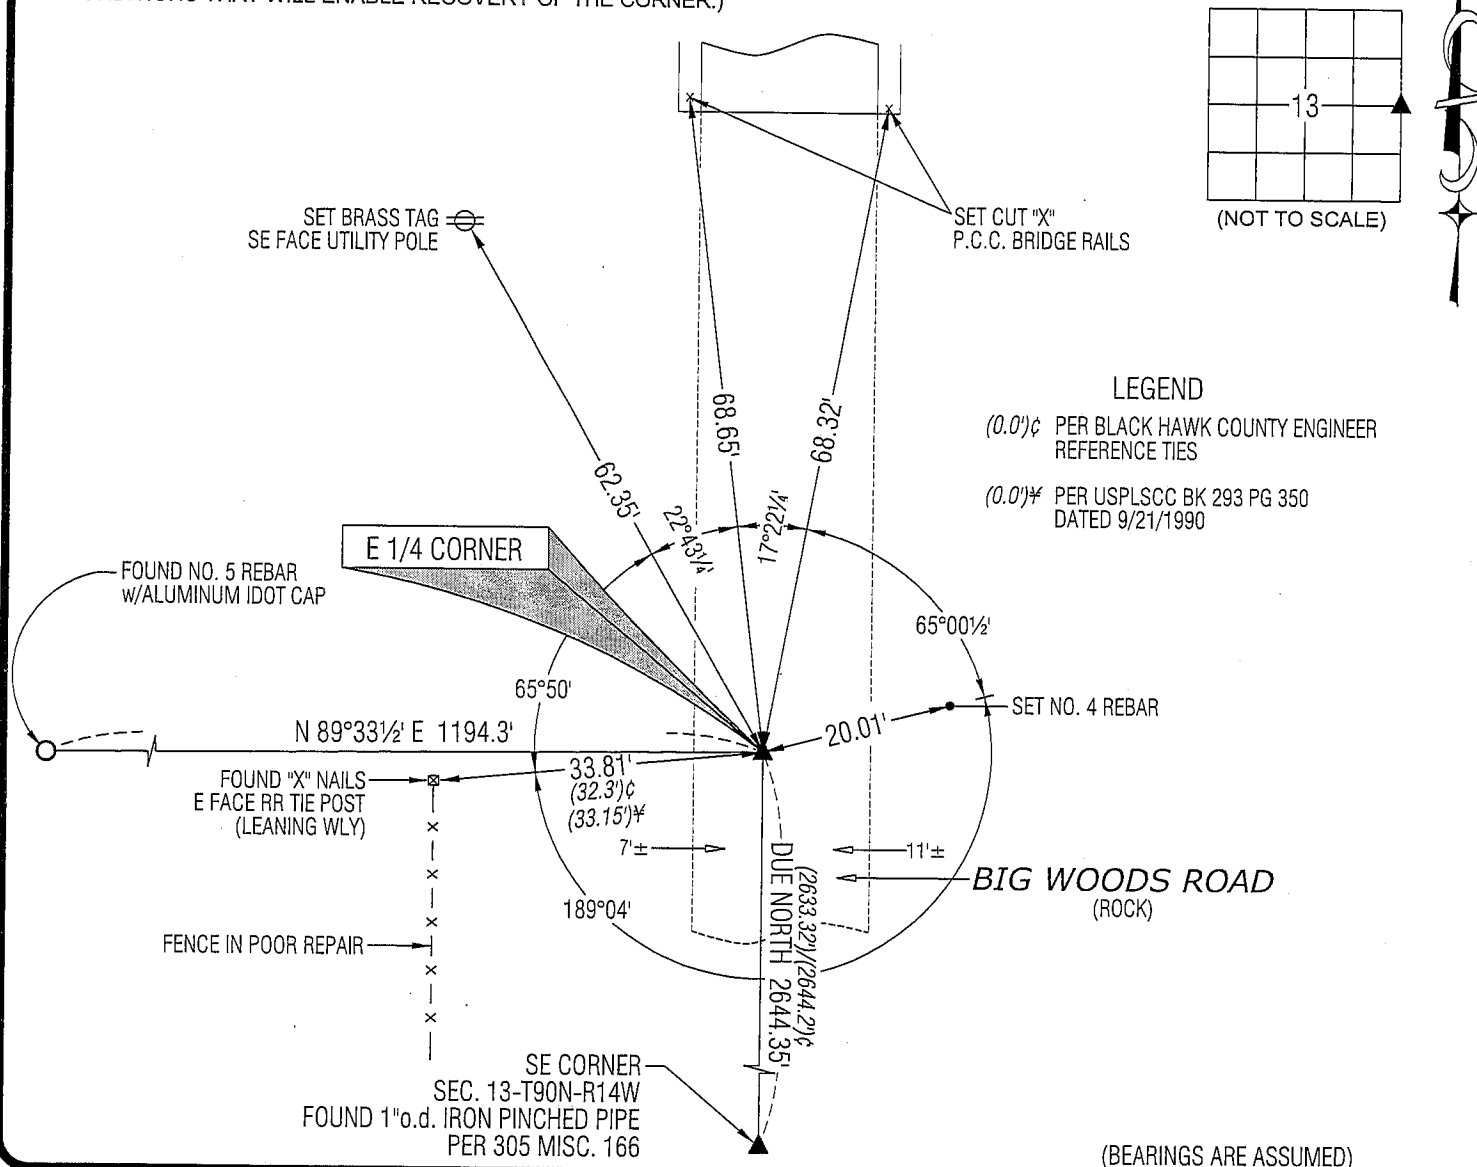

HELLAND ENGINEERING & SURVEYING, LTD.

1107 Technology Parkway
Cedar Falls, Iowa 50613-6951
(319)-266-0161

SHINER = 8D NAIL & 1 5/16"Ø METAL SHINER
BRASS TAG = 13/16"Ø BRASS TAG
OPC = PLASTIC CAP (O=ORANGE, R=RED, Y=YELLOW)
(00') RECORDED AS FILE NAME: 09-177C2.DWG

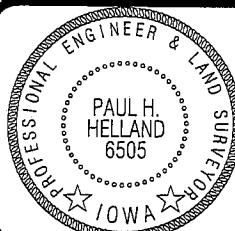

I hereby certify that this land surveying document was prepared
and the related survey work was performed by me or under my
direct personal supervision and that I am a duly licensed Land
Surveyor under the laws of the State of Iowa.

Jeffrey P. Helland 6/7/09
Paul H. Helland
License Number 6505
My license renewal date is December 31, 2009.
All pages or sheets are covered by this seal except:

LIST CORNERS TO BE INDEXED

CORNER	SECTION	TOWNSHIP	RANGE
E 1/4 CORNER	13	90N	14W
W 1/4 CORNER	18	90N	13W