

SC
MISC ✓
INDEX ✓
MARGIN ✓
PROOF ✓
COMPARE ✓

BLACK HAWK COUNTY IOWA: SS
Filed for record Jul 25, 1997 at
4:00 P.M. and recorded in Book 326
of MISC Page 429
Richard L. King Recorder
Fee N/C
ENGINEER'S OFFICE

County Assessor

1709

PREPARED BY: BLACK HAWK COUNTY ENGINEERS OFFICE
316 E. FIFTH STREET, ROOM 211 WATERLOO, IOWA 50703

PH.# (319) 291-2419
FAX# (319) 291-2461

SLSI 9-94
CERT 12-96


UNITED STATES PUBLIC LAND SURVEY CORNER CERTIFICATE OF
Land Survey Monuments situated in Section 14, Township 90 N,
Range 14 W, of the Fifth Principal Meridian, BLACK HAWK County, Iowa.
Previously recorded in Book N/A, Page N/A, in County Recorder's Office.

(Show reason for preparing this certificate, the evidence and detailed procedures used in establishing the corner positions and monumentation found or placed.)


Monument Description and Remarks: RESET 5/8" REBAR FLUSH WITH A.C.C.
SURFACE, LOC. CENTERLINE WAVERLY RD. (OLD HWY. 218), ALIGNED WITH
STOCKADE FENCE TO EAST. FIELD REFERENCED 3 PREV. REF. TIES AND
RESET ONE DISTURBED REFERENCE AS DENOTED.
E. 1/4 CORNER, SECTION 14-90-14.
MON. RE-EST, 1996 RESURFACING PROJECT.

PLAN - VIEW

(Show a minimum of three reference ties to durable physical objects, relevant monuments and physical conditions that will enable recovery of the corner.)

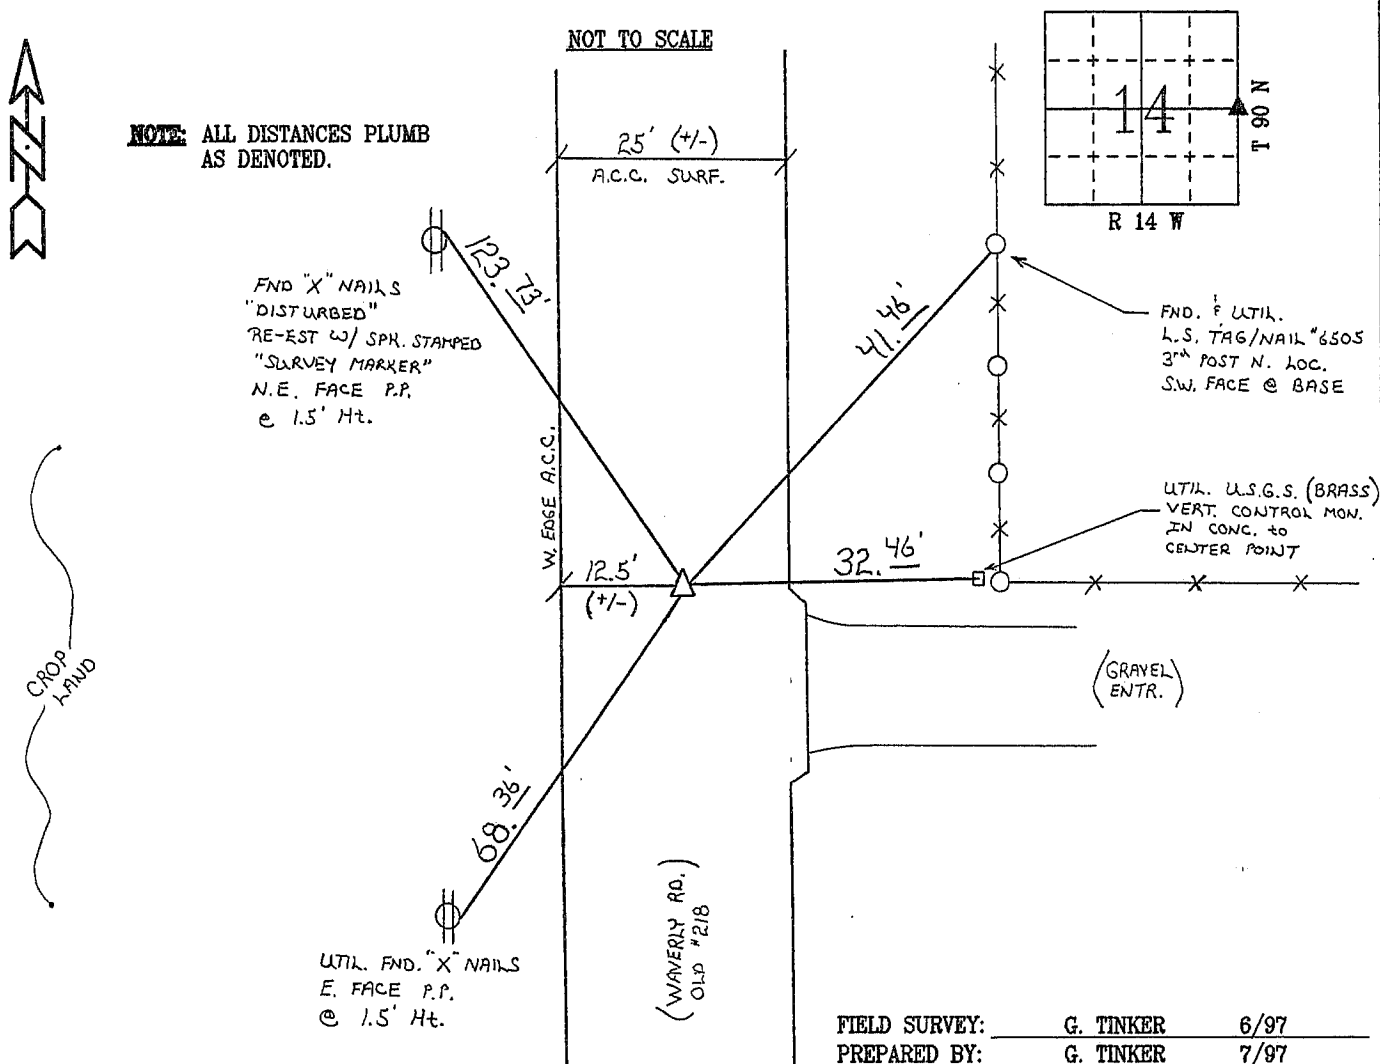

CERTIFICATION

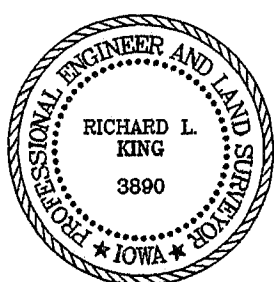

I hereby certify that this land surveying document was prepared and the related survey work was performed by me or under my direct personal supervision and that I am a duly licensed Land Surveyor under the laws of the State of Iowa.

Richard L. King 7/25/99
Richard L. King (date)

License Number 3890

My license renewal date is December 31, 1997

Pages or sheets covered by this seal:

This Land Corner Certificate Only.

LIST CORNERS TO BE INDEXED

Corner Section - Township - Range

E. 1/4 14 90 N 14 W