
Recorded: 02/28/2019 at 0 Fee Amt: \$0.00 Page 1 of Black Hawk County Iowa SANDIE L. SMITH RECORDER

File 2019-00013002

Prepared by & Return to: Herold - Reicks Surveying, 2206 East Bremer Avenue, Waverly, IA 50677, Ph. 319-483-5187 **United States Public Land Survey Corner Certificate** Land Survey Monument situated in Section 14, Township 90 North, Range 14 West of the Fifth Principal Meridian, Black Hawk County, Iowa. On file in **Document #2017-00015877** in the County Recorder's Office. There is no certificate on file for this corner. This certificate is being prepared in compliance There are no longer three valid ties of record. with Iowa Code Chapter 355.11 because: There are changes to reference ties of record. There is change of monumentation of record. X To clarify description of record monument (ties). **Monument Description and Remarks:** Northeast 1/4 Corner: The previously recorded Section Corner Certificate, indicates Found 5/8"Ø Rebar, said monument was removed during highway reconstruction. The position of said Section Corner was reestablished with information obtained from previously recorded Section Corner Certificate. Set 1"Ø Bronze Survey Marker PLS 22468 at said position to perpetuate the Corner. Corner reset in conjunction with Project No. FM-C007(150)--55-07. Plan View (Show a minimum of three reference ties to durable physical objects, relevant monuments and physical conditions that will enable recovery of the corner.) Sec. 14 T90N R14W 14 Iowa State Trapshooting Sign

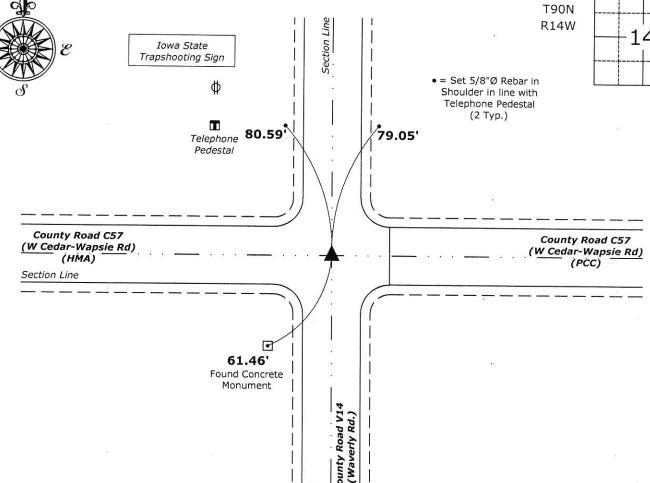

Northeast Corner of Section 14-90-14 Set 1"Ø Bronze Survey Marker PLS 22468



I hereby certify that this land surveying document was prepared and the related survey work was performed by me or under my direct personal supervision and that I am a duly licensed Land Surveyor under the laws of the State of Iowa.

Isaid	m.	Rust	2-25-19
Isaiah M. Reicks			Date:

License number 22468

My license renewal date is December 31, 2019. Sheets covered by this seal: Individual sheet only

	Corner	Section	Twp.	Range				
	NE	14	90	14				
				*				

List Corner to be Indexed

Project Number: 2018-855 FB: Black Hawk 10, Pg. 37

Projects - WO\2018\Construction\2018-855 Janesville - Waverly Road\2018-855.dwg, 2/25/2019 1:01:01 PM