

UNITED STATES PUBLIC LAND SURVEY CORNER CERTIFICATE

OF

Land Survey Monuments situated in Section 14, Township 90, Range 14,
of the Fifth Principal Meridian, BLACK HAWK County, Iowa.
Previously recorded in Book _____, Page _____.

(Show reason for preparing this certificate, the evidence and detailed procedures used in establishing the corner positions and monument found or placed.)


Monument Description and Remarks: SURVEY DONE IN SW 1/4 OF SEC. 11-90-14

NW CORNER SEC 14 - FOUND PIN

N 1/4 COR SEC 14 - FOUND PIN

PLAN - VIEW

(Show a minimum of three reference ties to durable physical objects, relevant monuments and physical conditions that will enable recovery of the corner.)

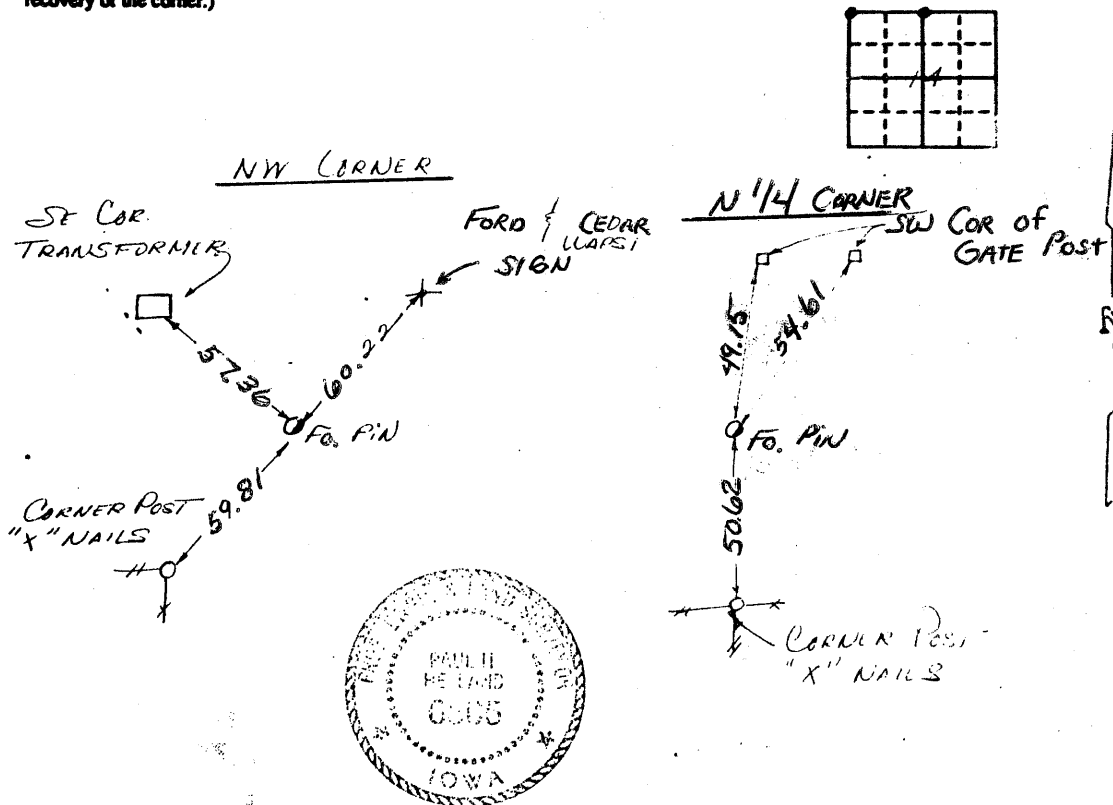

I hereby certify that the survey work was completed and this certificate was prepared by me or under my direct personal supervision and that I am a duly registered land surveyor under the laws of the state of Iowa.

Paul H. Hedrick 12531191

REGISTERED LAND SURVEYOR NO. 6505

SEAL

List Corners to be Indexed

Corners	Section	Twp	Range
NW	14	90	14
N 1/4	14	90	14

MISC. BK. 299 p. 599

BOOK 200 PAGE 500