

Wayne Claassen Engineering and Surveying, Inc.
P.O. BOX 898 Waterloo, Iowa 50704-0898



PHONE: (VOICE) 319-235-6294
(FAX) 319-235-0028

UNITED STATES PUBLIC LAND SURVEY CORNER CERTIFICATE

Land Survey Monuments situated in Section 14, Township 90 North, Range 14 West, of the Fifth Principal Meridian, Black Hawk County, Iowa.
Previously recorded in _____ in County Recorder's Office.
(book, page, document number, etc.)

Monument Description and Remarks
Set 1/2"x24" iron pin and red cap #16775 at mid point between SW Corner and W 1/4 Corner.

- Reason for filing certificate:
☒ There is no certificate on file with the Recorder's Office.
☐ Accepts corner position which differs from the one shown in above document.
☐ The corner monument was replaced or modified.
☐ The reference ties in above document were incorrect or missing.
- PLAN - VIEW

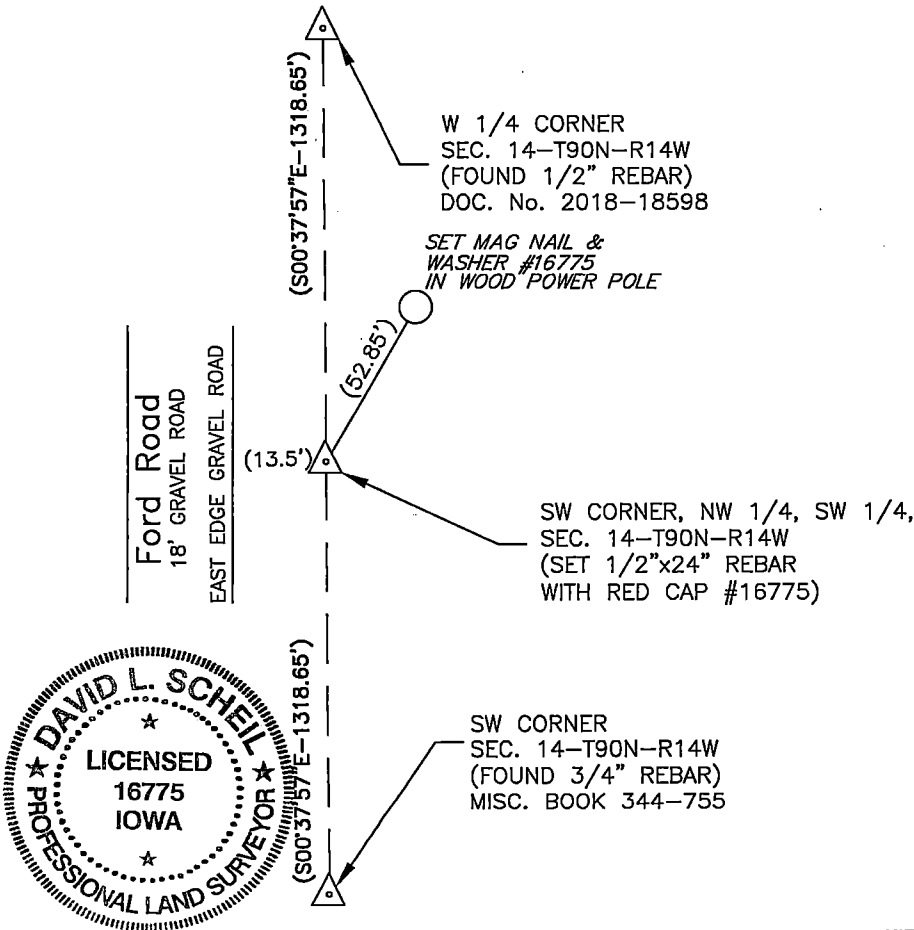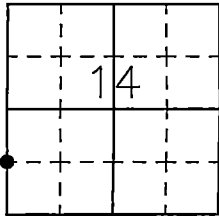

Iowa State Plane Coordinate System
(North Zone, 2011 Adj.)
N= 3684351
E= 5197161
(for location purposes only)

764-10

I hereby certify that this land surveying document was prepared and the related survey work was performed by me or under my direct personal supervision and that I am a duly Licensed Land Surveyor under the laws of the State of Iowa.

Signature: David L. Schell
David L. Schell, L.S.
Date: July 14, 2021 Lic. No. 16775
Pages or Sheets Covered by this Seal: THIS SHEET ONLY.
My license renewal date is December 31, 2022
SEAL

List Corners to be Indexed			
Corners	Section	Twp	Range
SW CORNER, NW 1/4, SW 1/4,	14	90 N	14 W
NE CORNER, SE 1/4, SE 1/4,	15	90 N	14 W