

UNITED STATES PUBLIC LAND SURVEY CORNER CERTIFICATE
OF


Land Survey Monuments situated in Section 15, Township 90, Range 14 WEST, of the Fifth Principal Meridian, BLACK HAWK County, Iowa.
Previously recorded in Book _____, Page _____.

(Show reason for preparing this certificate, the evidence and detailed procedures used in establishing the corner positions and monumentation found or placed.)

Monument Description and Remarks: FOUND STD. CONCRETE MONUMENT STAMPED 16 | 15
EXPOSED 0.3 21 | 22

PLAN - VIEW

(Show a minimum of three reference ties to durable physical objects, relevant monuments and physical conditions that will enable recovery of the corner.)

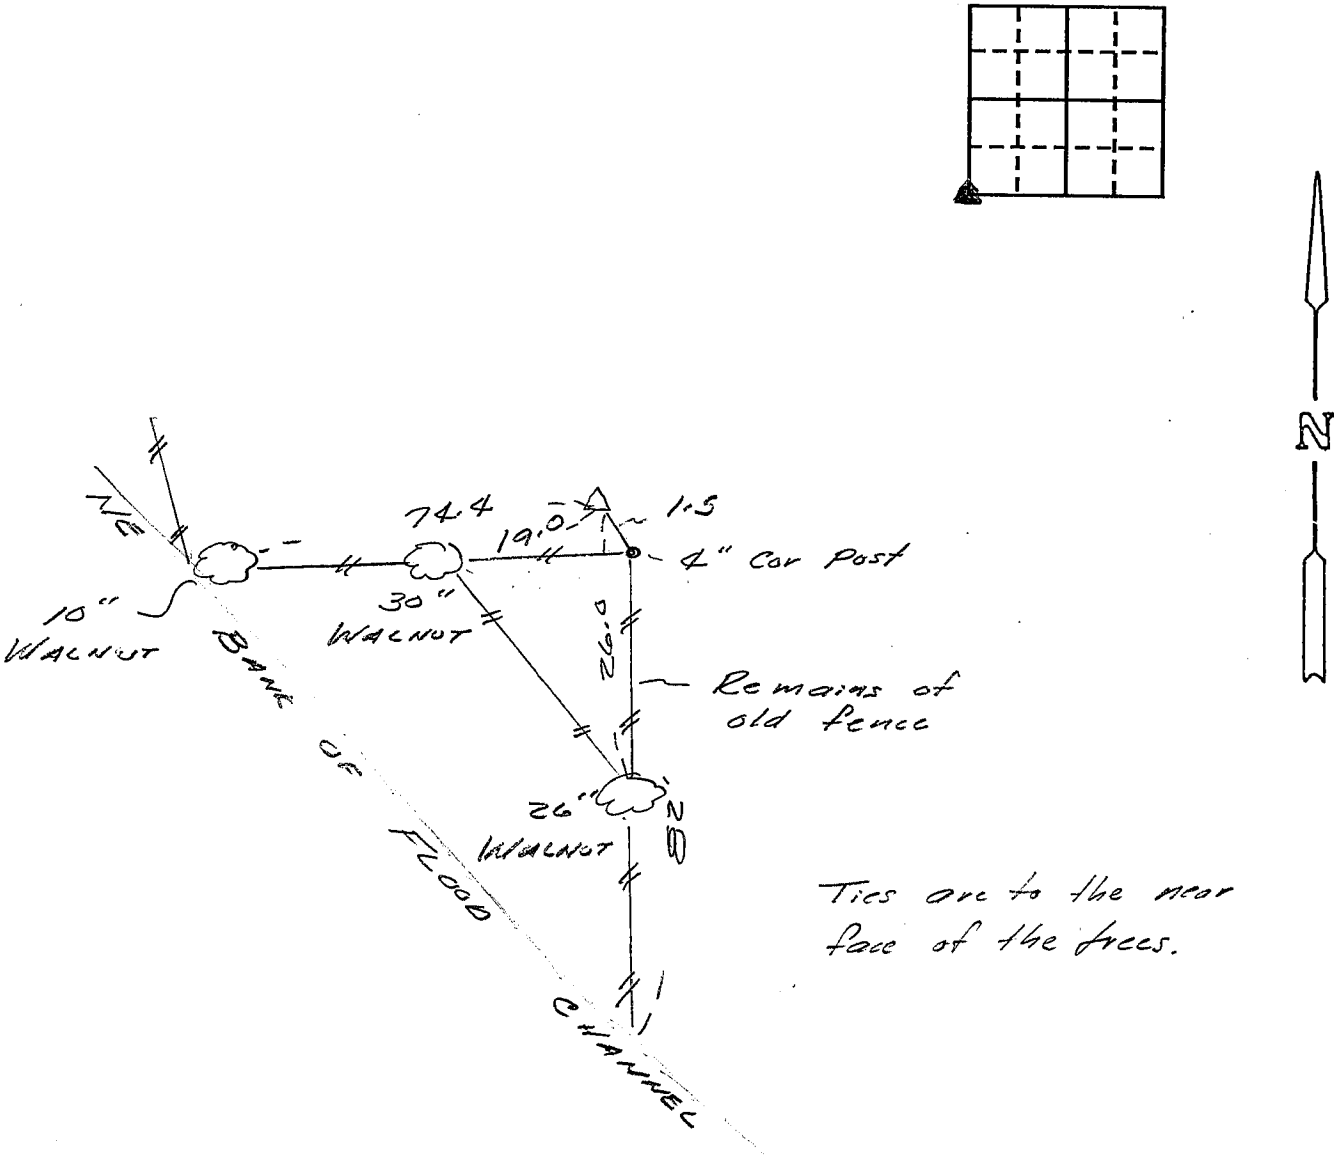

I hereby certify that the survey work was completed and this certificate was prepared by me or under my direct personal supervision and that I am a duly registered land surveyor under the laws of the state of Iowa.

J. Leroy Nugteren
REGISTERED LAND SURVEYOR NO. 6708

SEAL



List Corners to be Indexed

Corners	Section	Twp	Range
NE	21	90	14
SE	15	90	14

2-14-2001

To date, this document is "NOT" recorded w/ Co. recorder.

J.T.