

Jeffrey P. Helland, 1107 Technology Parkway, Cedar Falls, Iowa 50613-6951, (319)-266-0161

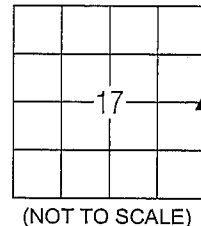
UNITED STATES PUBLIC LAND SURVEY CORNER CERTIFICATE
OFLAND SURVEY MONUMENTS SITUATED IN SECTION NO. 17, TOWNSHIP NO. 90 NORTH, RANGE
NO. 14 WEST OF THE FIFTH PRINCIPAL MERIDIAN, BLACK HAWK COUNTY, IOWA.
PREVIOUSLY RECORDED IN N/A(SHOW REASON FOR PREPARING THIS CERTIFICATE, THE EVIDENCE AND DETAILED PROCEDURES USED IN ESTABLISHING THE
CORNER POSITIONS AND MONUMENTATION FOUND OR PLACED.)

MONUMENT DESCRIPTION AND REMARKS:

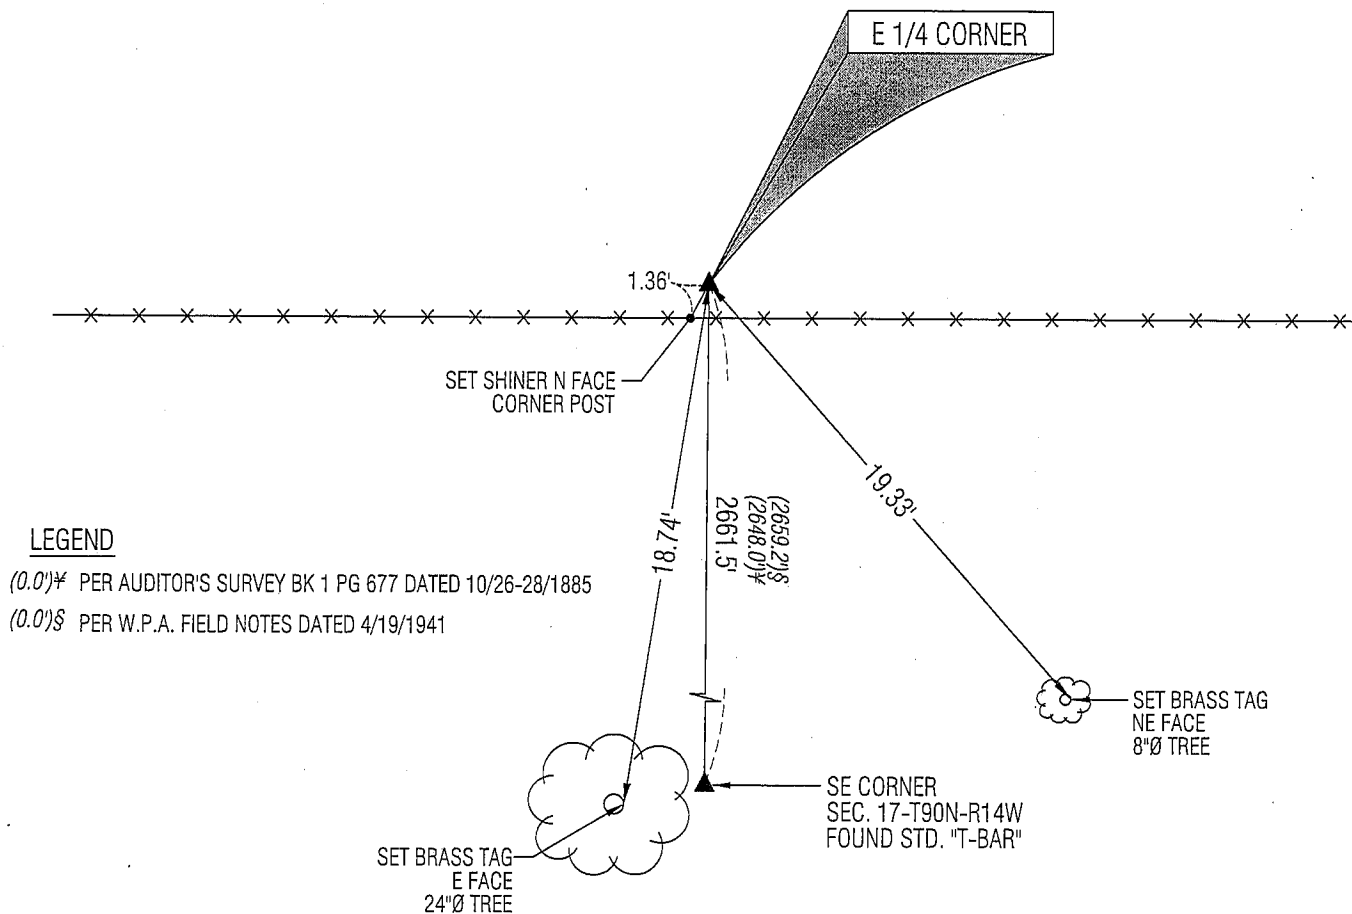
NO USPLSCC ON FILE. SURVEY COMPLETED IN THE SE 1/4 OF SEC. 17-T90N-R14W.

→ **E 1/4 CORNER:** SURVEY RECORD BK 1 PG 677 DATED 10/26-28/1885 CALLS FOR [STONE & STAKE]. WPA NOTES DATED 4/10/1941 CALLS FOR [FOUND NIGGERHEAD STONE 18"x7"x11"; 0.2' NORTH OF MIDPOINT OF MILE, S.C.M. FLUSH WITH GND.]. PLAT OF SURVEY BY CLEO E. McCALL (UNDATED) CALLS FOR [FOUND CONC. MONUMENT]. PLAT OF SURVEY BY HAROLD D. BLESSING DATED 2/21/1977 CALLS FOR [FOUND CONC. MONUMENT]. FOUND NO. 4 REBAR w/OPC #6505 0.5' DEEP ABOVE CONCRETE MONUMENT 2' DEEP. UTILIZED SAID REBAR AS CORNER.

PLAN VIEW

(SHOW A MINIMUM OF THREE REFERENCE TIES TO DURABLE PHYSICAL OBJECTS, RELEVANT MONUMENTS AND PHYSICAL
CONDITIONS THAT WILL ENABLE RECOVERY OF THE CORNER.)

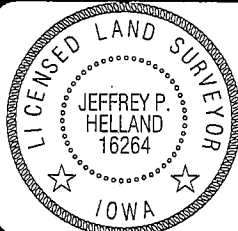
(NOT TO SCALE)



LEGEND

(0.0')# PER AUDITOR'S SURVEY BK 1 PG 677 DATED 10/26-28/1885

(0.0')\$ PER W.P.A. FIELD NOTES DATED 4/19/1941

HELLAND ENGINEERING & SURVEYING, LTD.
1107 Technology Parkway
Cedar Falls, Iowa 50613-6951
(319)-266-0161SHINER = 8D NAIL & 1 5/16" Ø METAL SHINER
BRASS TAG = 13/16" Ø BRASS TAG
OPC = PLASTIC CAP (O=ORANGE, R=RED, Y=YELLOW)
(00') RECORDED AS FILE NAME: 08-264C4.DWGI hereby certify that this land surveying document was prepared
and the related survey work was performed by me or under my
direct personal supervision and that I am a duly licensed Land
Surveyor under the laws of the State of Iowa.Jeffrey P. Helland 9/2/08
Jeffrey P. Helland
License Number 16264
My license renewal date is December 31, 2009.
All pages or sheets are covered by this seal except:

LIST CORNERS TO BE INDEXED

| CORNER | SECTION | TOWNSHIP | RANGE |
|--------------|---------|----------|-------|
| E 1/4 CORNER | 17 | 90N | 14W |
| W 1/4 CORNER | 16 | 90N | 14W |