

Doc ID: 004991550001 Type: GEN Kind: CORNER Recorded: 12/05/2012 at 01:42:18 PM Fee Amt: \$0.00 Page 1 of 1 Black Hawk County Iowa JUDITH A MCCARTHY RECORDER

File 2013-00011525

PREPARED BY: \* BLACK HAWK COUNTY ENGINEERS OFFICE 316 E. FIFTH STREET, ROOM 211 WATE

WATERLOO, IOWA 50703

PH.# (319) 833-3008 FAX.# (319) 833-3139

SLSI 9-94 BHCO 03-09

UNITED STATES PUBLIC LAND SURVEY CORNER CERTIFICATE OF

\_\_ , Township<u>90 N</u> Land Survey Monuments situated in Section\_ 18 Range 14 W, of the Fifth Principal Meridian, BLACK HAWK County, Iowa.


Previously recorded in Misc Book 294, Page 938, in County Recorder's Office.

(Show reason for preparing this certificate): The corner monument has been Replaced or Modified, per Ia. Code 355.11(1)(c)


(Evidence and detailed procedures used in establishing the corner position(s) and monumentation found or placed.)

Monument Description and Remarks: N.E. CORNER

CORNER RESET & TIES UPDATED PER H.M.A. RESURF. PROJECT LFM-503--7X-07. PRIOR TO RESURF. PROJECT, FOUND 5/8" (#5) REBAR (vs. 3/4" PIN) PER CURRENT RECORD AND TEMP. REF. COR. LOCATION PER RTK GPS. AFTER 1.5" DEEP MILL & REFILL W/INTERMED. COURSE H.M.A., NO SOUNDING REMAINING @ LOCATION. AFTER ADDITIONAL 1.5" H.M.A. SURFACE COURSE, RESET CORNER WITH 5/8" (#5) x ±8"L REBAR LOCATED @ ±0.4" NORTH OF C.L. H.M.A. JOINT, AND ALIGNED (±) WITH CENTERLINE SIDE ROAD TO SOUTH.

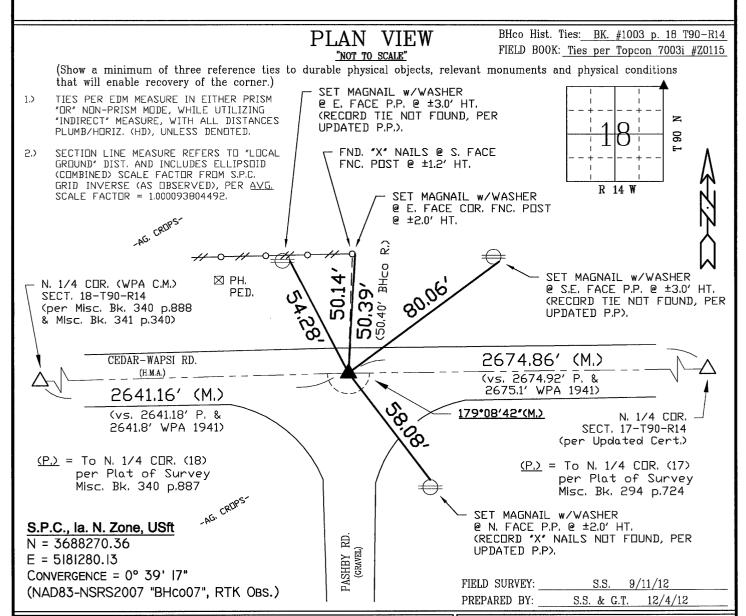



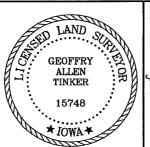

I hereby certify that this land surveying document was prepared and the related survey work was performed by me or under my direct personal supervision and that I am a duly licensed Land Surveyor under the laws of the State of Iowa.

104/2012

15748

My license renewal date is December 31, 2012

Pages or sheets covered by this seal:

This Land Corner Certificate Only

LIST	CORNERS T	O BE I	NDEXED	
Corner	<u>Section</u> -	Town	<u>ıship</u> –	Range
N.E. Cor.	1	90	N	15 W
N.W. Cor.	6	90	N	14 W
S.E. Cor.	36	91	N	15 W
S.W. Cor.	31	91	N	14 W
INDEX OF ABBREVIATIONS				
(M) = "Measured" Dimension "NP" = Reflectorless EDM Meas.				
M) = "Measured" Dimension "NP" = Reflectorless EDM Meas. P) = "Platted" Dimension "MLM" = Indirect Measure				

"Record" Dimension
"Calculated" Dimension

"CM" = Concrete Monument
"SM" = Survey Marker Spike/Tag
"PK" = PK/MAG Nail Brand Style