

SC  
MISC  
INDEX 515  
MARGIN  
PROOF  
COMPARE

BLACK HAWK COUNTY IOWA:SS  
Filed for record DEC 19 2000  
1:00 P.M. and recorded in Book 341  
of MISC Page 340  
Recorder  
FEE 1-5.00/  
ROBERT HAYLOCK  
PO BOX 549  
PARKERSBURG, IOWA 50665  
319-346-1741

ROBERT HAYLOCK

P.O. BOX 549

PARKERSBURG, IOWA 50665

IA 50665

319-346-1741

## UNITED STATES PUBLIC LAND SURVEY CORNER CERTIFICATE

Land Survey Monuments situated in Section 18, Township 90 N, Range 14 W, of the Fifth Principal Meridian, Black Hawk County, Iowa.


Previously recorded in N.A. in County Recorder's Office.  
(book, page, document number, etc.)

(Show reason for preparing this certificate, the evidence and detailed procedures used in establishing the corner positions and monumentation found or placed.)

Monument Description and Remarks: NW cor - Found 2" Gas pipe at intersection of North-south and east-west road.  
W 1/4 cor - found 2" Gas pipe on line with fence to the east. N 1/4 cor found pin at P.I. of road.

### PLAN - VIEW

(Show a minimum of three reference ties to durable physical objects, relevant monuments and physical conditions that will enable recovery of the corner)

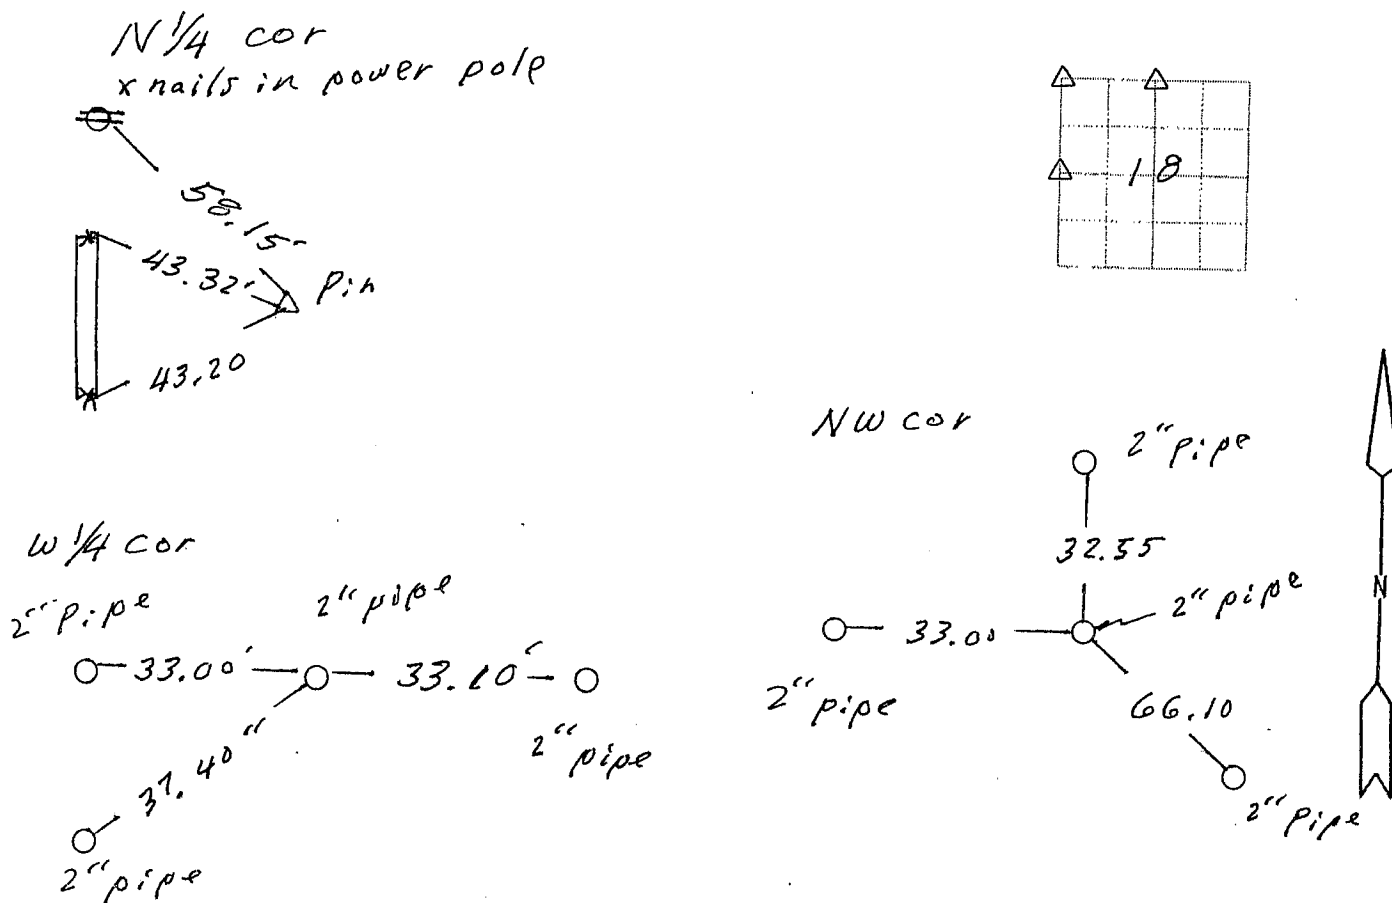


I hereby certify that the survey work was completed and this land surveying document was prepared by me or under my direct personal supervision and that I am a duly licensed land surveyor under the laws of the state of Iowa

Signature: R. L. Haylock  
Name typed or printed

Date: 11-30-00 Reg. No. 5680

My license renewal date is December 31, 2000

SEAL

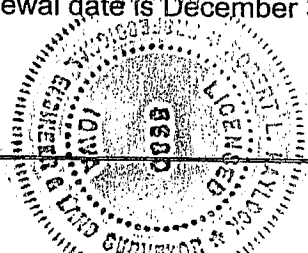

Corners	List Corners to be Indexed		
	Section	Twp	Range
NW cor	18	90 N	14 W
W 1/4 cor	18	90 N	14 W
N 1/4 cor	18	90 N	14 W