

✱ Paul H. Helland, 1107 Technology Parkway, Cedar Falls, Iowa 50613-6951, (319)-266-0161

UNITED STATES PUBLIC LAND SURVEY CORNER CERTIFICATE OF

LAND SURVEY MONUMENTS SITUATED IN SECTION NO. 22, TOWNSHIP NO. 90 NORTH, RANGE
 NO. 14 WEST OF THE FIFTH PRINCIPAL MERIDIAN, BLACK HAWK COUNTY, IOWA.

PREVIOUSLY RECORDED IN N/A

(SHOW REASON FOR PREPARING THIS CERTIFICATE, THE EVIDENCE AND DETAILED PROCEDURES USED IN ESTABLISHING THE
 CORNER POSITIONS AND MONUMENTATION FOUND OR PLACED.)


MONUMENT DESCRIPTION AND REMARKS:

NO USPLSCC ON FILE. SURVEY COMPLETED IN THE NW 1/4 OF SEC. 23-T90N-R14W.

→ **NE CORNER OF SE 1/4 NE 1/4:** NO BLACK HAWK COUNTY ENGINEER TIES AVAILABLE. SEARCHED AREA WITH METAL
 DETECTOR BUT NOTHING FOUND. SET NO. 4 REBAR w/OPC #6505 0.3' DEEP ON LINE BETWEEN E 1/4 CORNER AND THE NE
 CORNER AND IN LINE WITH FENCES RUNNING EAST AND WEST.

PLAN VIEW

(SHOW A MINIMUM OF THREE REFERENCE TIES TO DURABLE PHYSICAL OBJECTS, RELEVANT MONUMENTS AND PHYSICAL
 CONDITIONS THAT WILL ENABLE RECOVERY OF THE CORNER.)

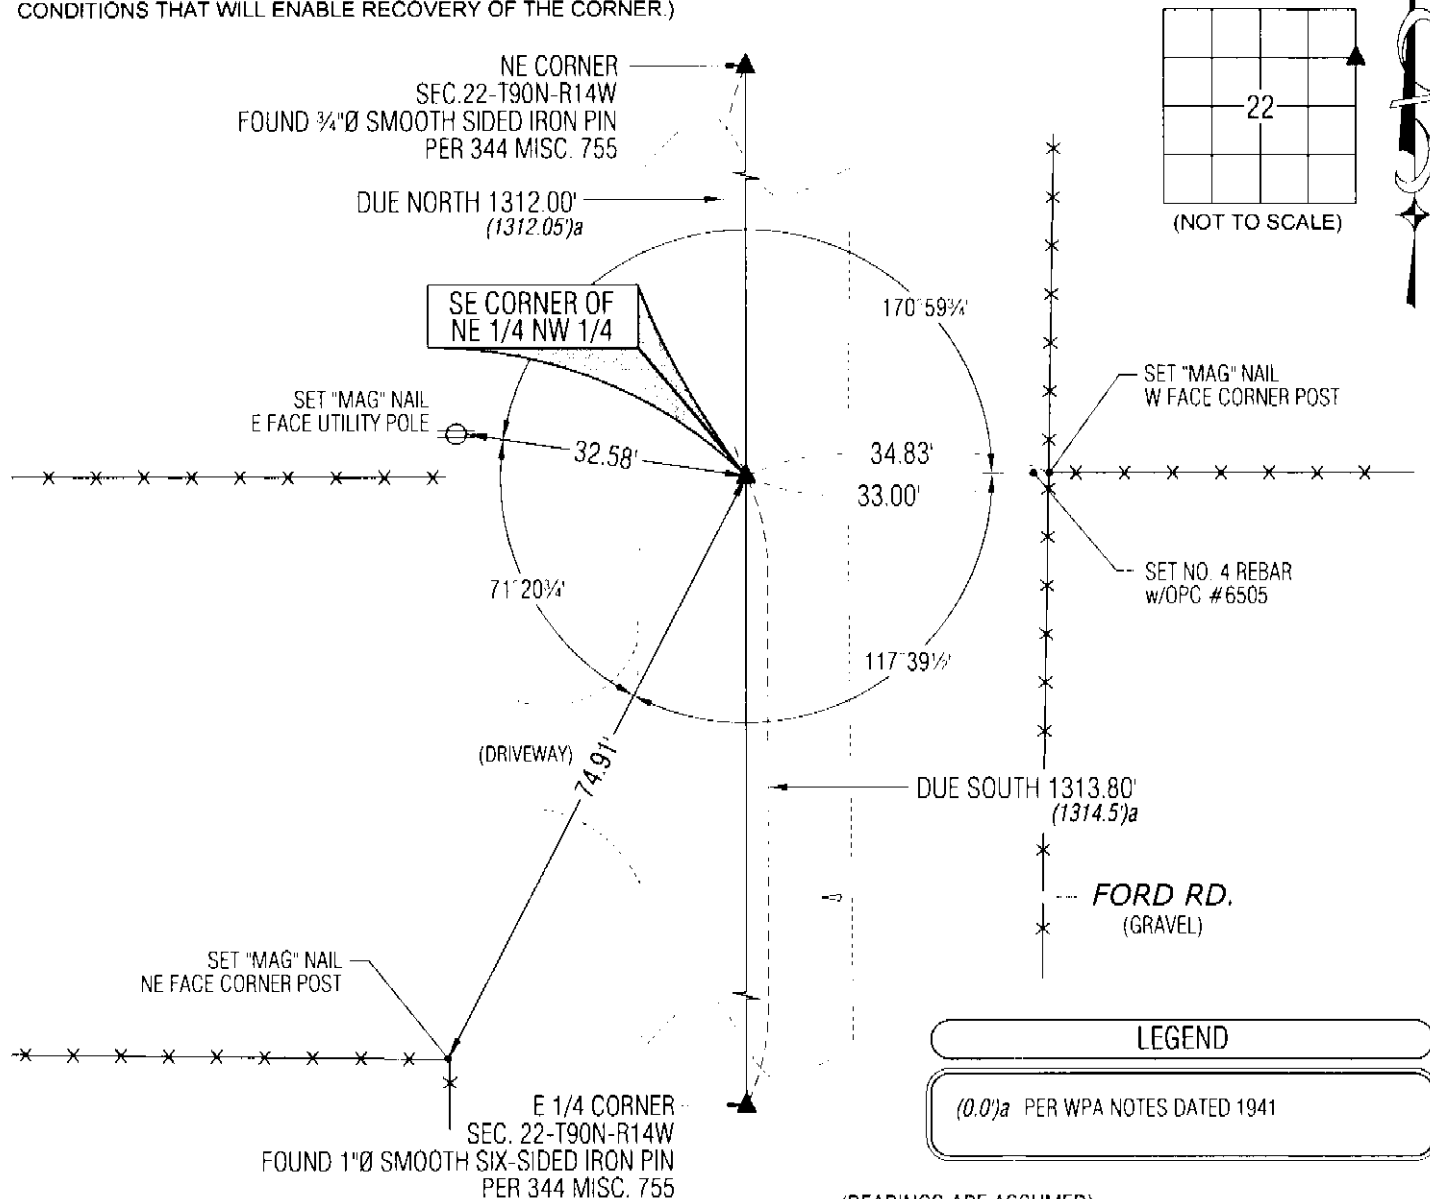


(BEARINGS ARE ASSUMED)



HELLAND ENGINEERING & SURVEYING, LTD.
 1107 Technology Parkway
 Cedar Falls, Iowa 50613-6951
 (319)-266-0161

SHINER = 8D NAIL & 1 5/16"Ø METAL SHINER
 BRASS TAG = 8D NAIL & 13/16"Ø BRASS TAG
 OPC = PLASTIC CAP (O=ORANGE, R=RED, Y=YELLOW)
 (00') RECORDED AS FILE NAME: 12-227-64.DWG

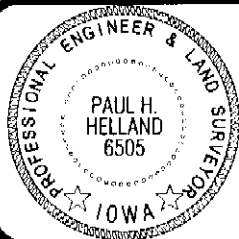

I hereby certify that this land surveying document was prepared
 and the related survey work was performed by me or under my
 direct personal supervision and that I am a duly licensed Land
 Surveyor under the laws of the State of Iowa.

Paul H. Helland 10/16/12
 Paul H. Helland
 License Number 6505
 My license renewal date is December 31, 2013.
 All pages or sheets are covered by this seal except:

LIST CORNERS TO BE INDEXED

CORNER	SECTION	TOWNSHIP	RANGE
NE COR. SE 1/4 NE 1/4	22	90N	14W
SE COR. NE 1/4 NE 1/4	22	90N	14W
SW COR. NW 1/4 NW 1/4	23	90N	14W
NW COR. SW 1/4 NW 1/4	23	90N	14W

File Number: 2013-00008053 Seq: 1