

Env
Prepared by & Return to: Herold - Reicks Surveying, 2206 East Bremer Avenue, Waverly, IA 50677, Ph. 319-483-5187

United States Public Land Survey Corner Certificate

Land Survey Monument situated in
Section 25, Township 90 North, Range 14 West of the Fifth Principal Meridian, Black Hawk County, Iowa.
Not on in the County Recorder's office.

This certificate is being prepared in compliance with Iowa Code Chapter 355.11 because:


- ☒ There is no certificate on file for this corner.
☐ There are no longer three valid ties of record.
☐ There are changes to reference ties of record.
☐ There is change of monumentation of record.
☐ To clarify description of record monument (ties).

Monument Description and Remarks:

Southwest Corner NE 1/4-NE 1/4: Found 1"Ø pinched pipe near an existing wood corner post. This monument is within 0.4' of the intersection of the 1/4-1/4 Section Lines of said Quarter Section. Accepted the monument as the 1/4-1/4 Corner.

Plan View

(Show a minimum of three reference ties to durable physical objects, relevant monuments and physical conditions that will enable recovery of the corner.)

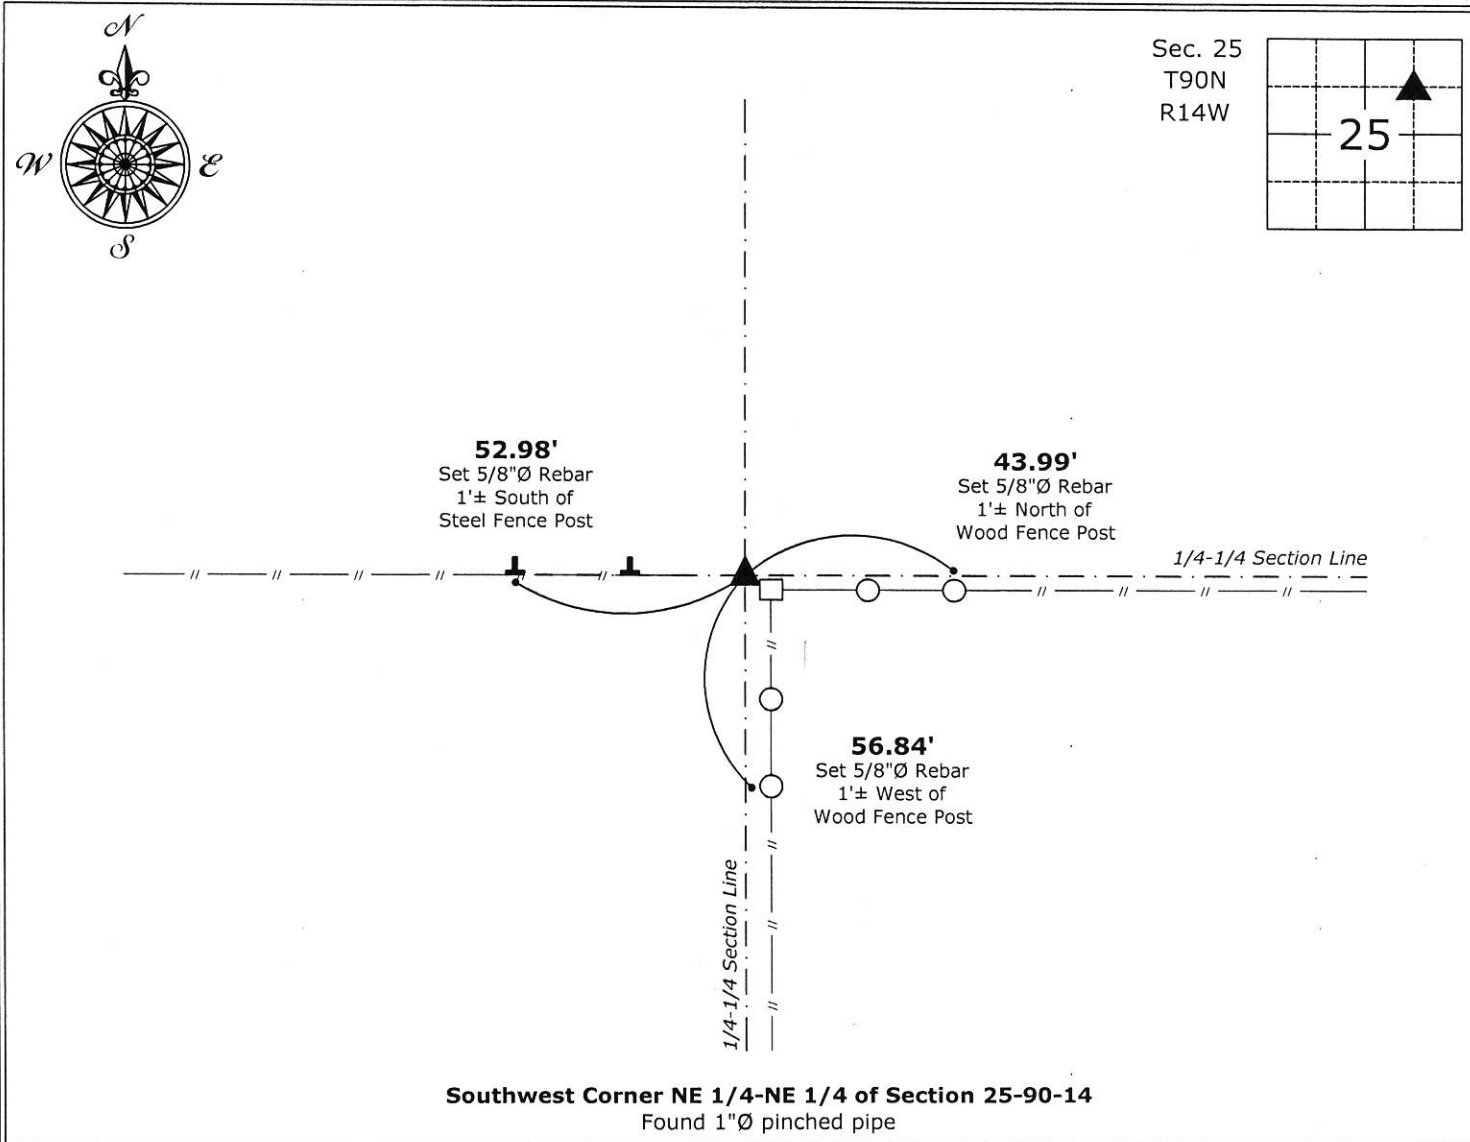

	I hereby certify that this land surveying document was prepared and the related survey work was performed by me or under my direct personal supervision and that I am a duly licensed Land Surveyor under the laws of the State of Iowa. <i>Isaiah M. Reicks</i> 1-29-19 Isaiah M. Reicks Date: License number 22468 My license renewal date is December 31, 2019. Sheets covered by this seal: Individual sheet only	<table><tr><th colspan="4">List Corner to be Indexed</th></tr><tr><th>Corner</th><th>Section</th><th>Twp.</th><th>Range</th></tr><tr><td>SW-NE-NE</td><td>25</td><td>90</td><td>14</td></tr></table> <table><tr><td>Project Number: 2018-569</td></tr><tr><td>FB: Black Hawk 10, Pgs. 33-34</td></tr></table>	List Corner to be Indexed				Corner	Section	Twp.	Range	SW-NE-NE	25	90	14	Project Number: 2018-569	FB: Black Hawk 10, Pgs. 33-34
	List Corner to be Indexed															
	Corner	Section	Twp.	Range												
SW-NE-NE	25	90	14													
Project Number: 2018-569																
FB: Black Hawk 10, Pgs. 33-34																