

SC ✓
MISC ✓
INDEX 9/8
MARGIN
PROOF
COMPARISON

BLACK HAWK COUNTY IOWA: SS
Filed for record Jul 25, 19 97 at
4:00 P.M. and recorded in Book 326
of MISC Page 426

Patricia S. Liso Recorder
Fee N/C
ENGINEER'S OFFICE

County Assessor

1706

PREPARED BY: BLACK HAWK COUNTY ENGINEERS OFFICE
316 E. FIFTH STREET, ROOM 211 WATERLOO, IOWA 50703

PH.# (319) 291-2419
FAX.# (319) 291-2461
SLSI 9-94
CERT 12-96

UNITED STATES PUBLIC LAND SURVEY CORNER CERTIFICATE OF
Land Survey Monuments situated in Section 26, Township 90 N,
Range 14 W, of the Fifth Principal Meridian, BLACK HAWK County, Iowa.
Previously recorded in Book N/A, Page N/A, in County Recorder's Office.


(Show reason for preparing this certificate, the evidence and detailed procedures used in establishing the corner positions and monumentation found or placed.)

Monument Description and Remarks: RESET 5/8" REBAR FLUSH WITH A.C.C.
SURFACE, LOC. CENTERLINE INTERSECTION WITH MT. VERNON ROAD. FIELD
REFERENCED PREV. I.D.O.T. MONUMENTS (4) AND INCLUDED TWO ADDITIONAL
TIES AS DENOTED.


N.E. CORNER, SECTION 26-90-14.
RE-EST, 1996 RESURFACING PROJECT.

PLAN - VIEW

(Show a minimum of three reference ties to durable physical objects, relevant monuments and physical conditions that will enable recovery of the corner.)

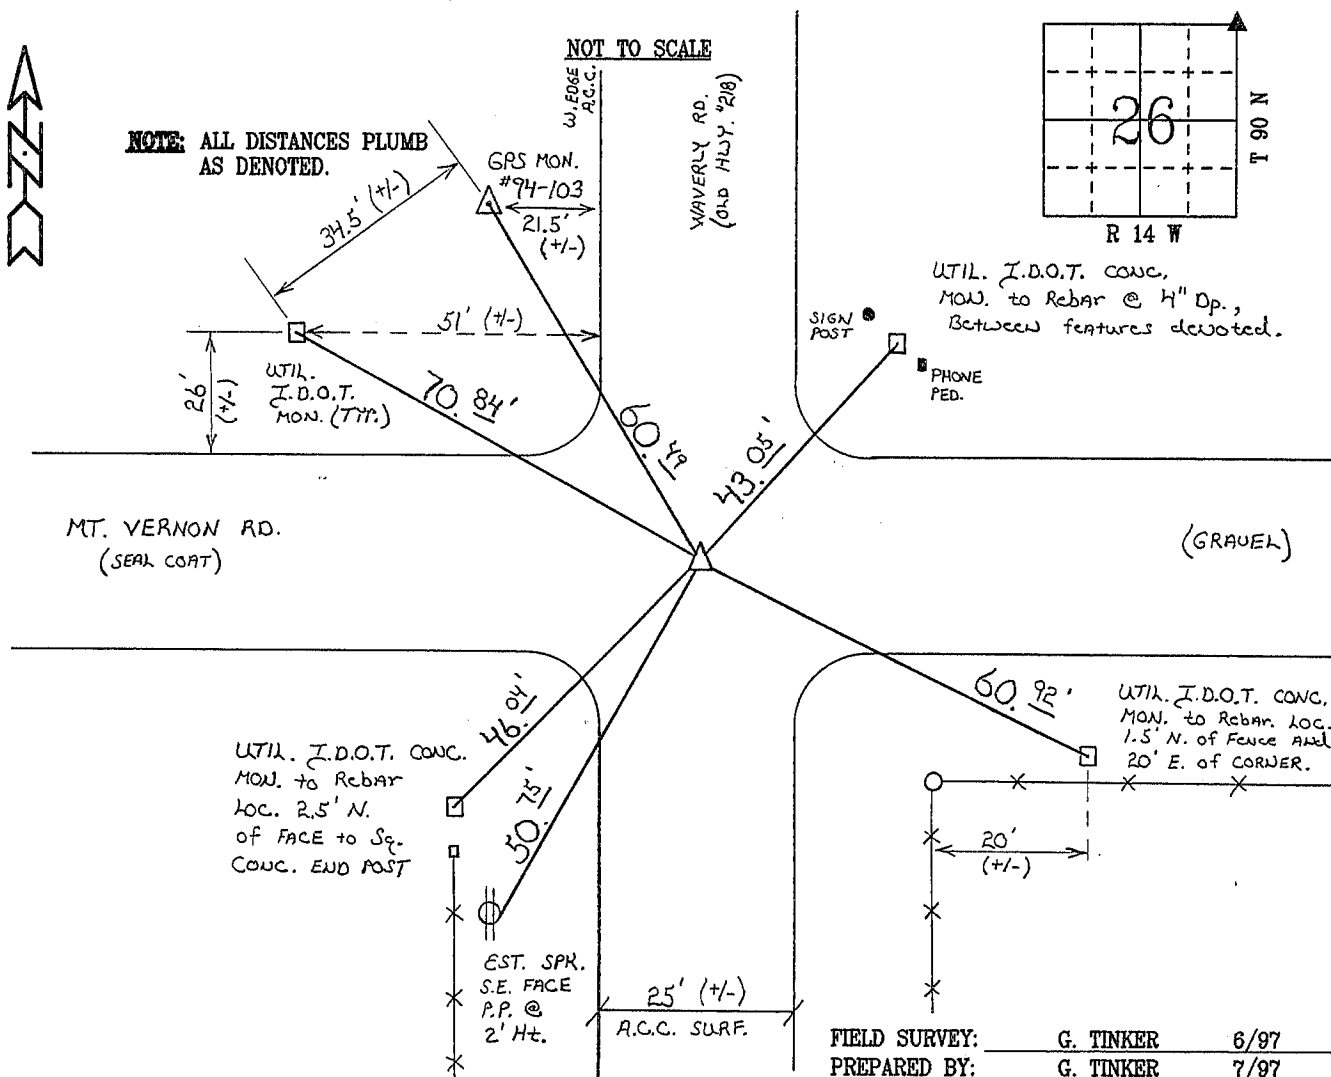

CERTIFICATION

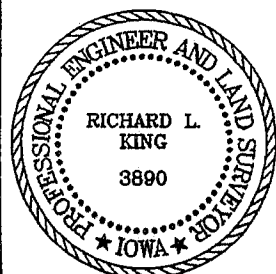

I hereby certify that this land surveying document was prepared and the related survey work was performed by me or under my direct personal supervision and that I am a duly licensed Land Surveyor under the laws of the State of Iowa.

Richard L. King 7/25/97 (date)
Richard L. King

License Number 3890

My license renewal date is December 31, 1997

Pages or sheets covered by this seal:

This Land Corner Certificate Only.

LIST CORNERS TO BE INDEXED

Corner	Section	Township	Range
NE COR.	26	90 N	14 W