
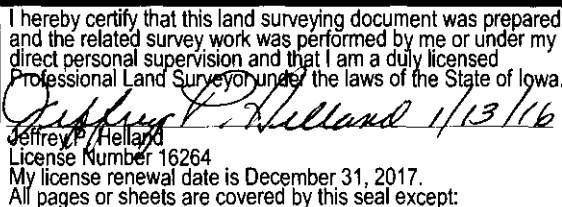


UNITED STATES PUBLIC LAND SURVEY CORNER CERTIFICATE
OF

NO USPLSCC ON FILE. SURVEY COMPLETED IN THE NE 1/4 SW 1/4 & NW 1/4 SE 1/4 1/2 OF SEC. 21-T90N-R14W.

(BEARINGS ARE ASSUMED)

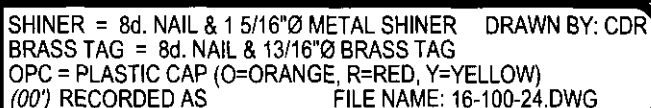

LIST CORNERS TO BE INDEXED			
CORNER	SECTION	TOWNSHIP	RANGE
N 1/4 CORNER	28	90N	14W
S 1/4 CORNER	21	90N	14W