

PROOF FILED FOR RECORD DEC 19, 2002, AT 4:00 P.M. FEE 1-5.00X

COMPARED

*Paul H. Helland*

BLACK HAWK COUNTY RECORDER

HELLAND ENGINEERING 1107 TECHNOLOGY PKWY CEDAR FALLS IA 50613-6951

Paul H. Helland, 1107 Technology Parkway, Cedar Falls, Iowa 50613-6951, (319)-266-0161

# UNITED STATES PUBLIC LAND SURVEY CORNER CERTIFICATE OF

LAND SURVEY MONUMENTS SITUATED IN SECTION NO. 30, TOWNSHIP NO. 90 NORTH, RANGE NO. 14 WEST OF THE FIFTH PRINCIPAL MERIDIAN, BLACK HAWK COUNTY, IOWA.

PREVIOUSLY RECORDED IN BOOK, PAGE.

(SHOW REASON FOR PREPARING THIS CERTIFICATE, THE EVIDENCE AND DETAILED PROCEDURES USED IN ESTABLISHING THE CORNER POSITIONS AND MONUMENTATION FOUND OR PLACED.)


## MONUMENT DESCRIPTION AND REMARKS:

NO CORNER CERTIFICATE ON FILE. SURVEY DONE IN SE 1/4 OF SEC. 24-T90N-R15W IN BUTLER COUNTY, IOWA.

→ NW CORNER: FOUND 2 1/2" o.d. GAS PIPE PER BLACK HAWK COUNTY ENGINEER REFERENCE TIES. CORNER IS 0.6' DEEP. SET "MAG" NAIL IN CENTER OF GAS PIPE TO BETTER LOCATE CENTER.

## PLAN VIEW

(SHOW A MINIMUM OF THREE REFERENCE TIES TO DURABLE PHYSICAL OBJECTS, RELEVANT MONUMENTS AND PHYSICAL CONDITIONS THAT WILL ENABLE RECOVERY OF THE CORNER.)

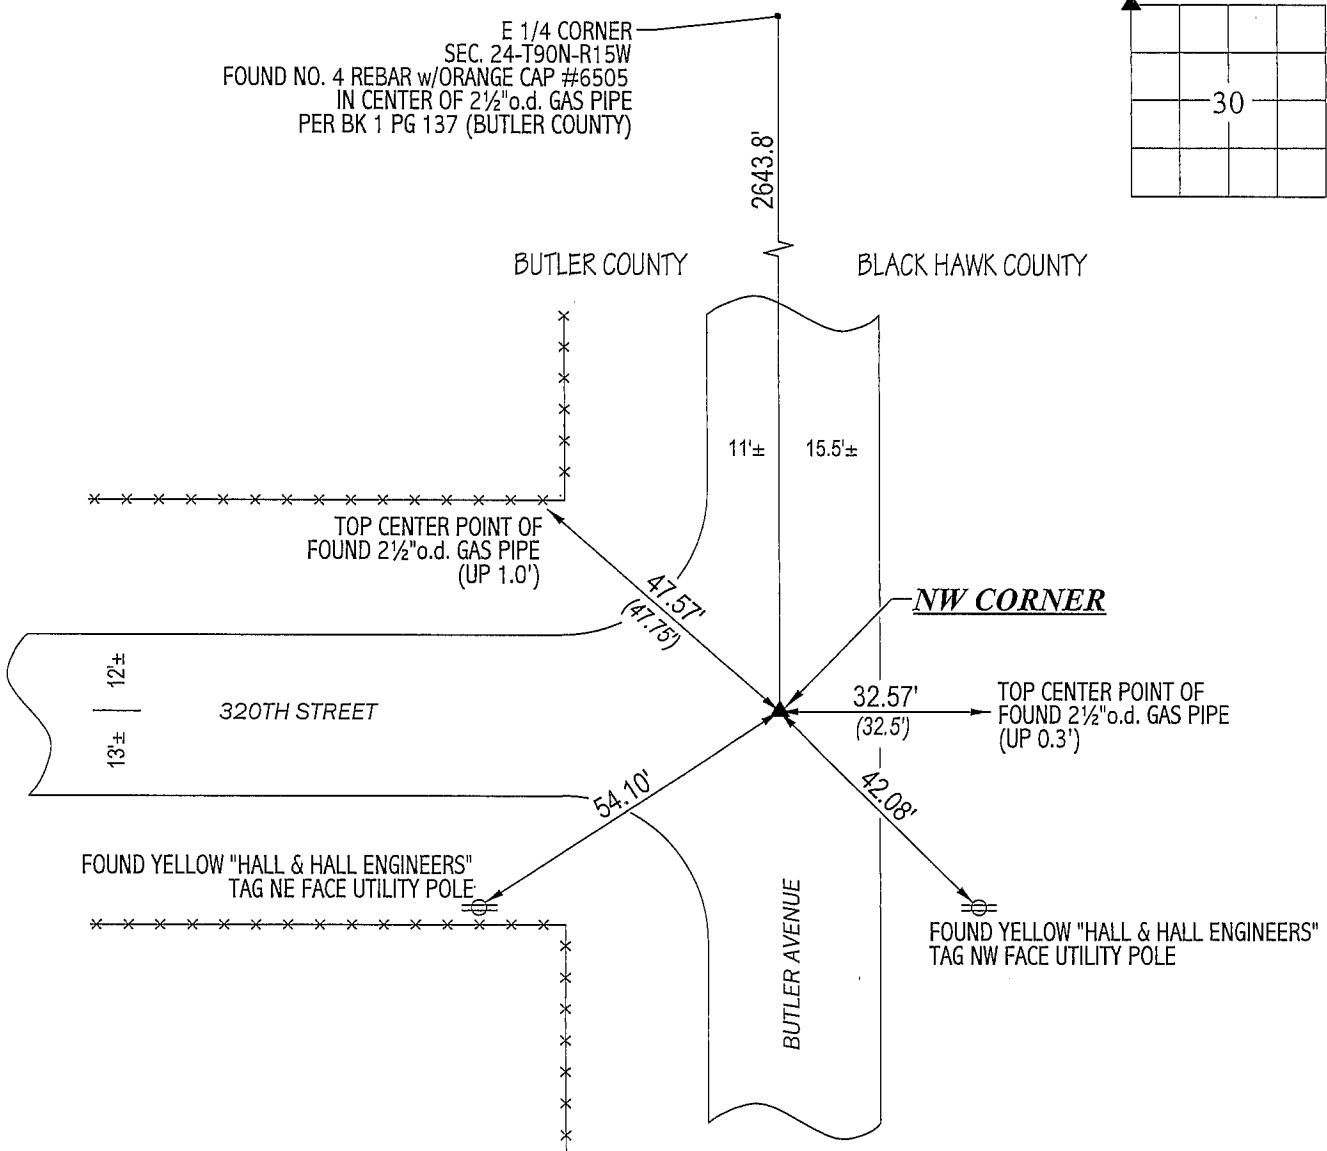


HELLAND ENGINEERING & SURVEYING, LTD.

1107 Technology Parkway  
Cedar Falls, Iowa 50613-6951  
(319)-266-0161

(00.00) - RECORDED AS

FILE NAME: 02-334C2.DRG

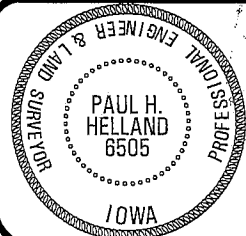

I hereby certify that this land surveying document was prepared and the related survey work was performed by me or under my direct personal supervision and that I am a duly licensed Land Surveyor under the laws of the State of Iowa.

*Paul H. Helland* 12/5/02

Paul H. Helland  
License Number 6505

My license renewal date is December 31, 2003.

All pages or sheets are covered by this seal except:

## LIST CORNERS TO BE INDEXED

CORNER	SECTION	TOWNSHIP	RANGE
NW CORNER	30	90N	14W