

INDEX
MARGIN
PROOF
COMPARE

BLACK HAWK COUNTY IOWA:SS 009297
Filed for record NOV 1, 2000 at
1:00 P.M. and recorded in Book _____
of _____ Page _____
Patricia J. Lass Recorder
Fee 1-5.00/
WAYNE CLAASSEN ENGINEERING AND SURVEYING

WAYNE CLAASSEN ENGINEERING AND SURVEYING, INC.
P.O. BOX 898 WATERLOO, IOWA 50704-0898

PHONE: (VOICE) 319-235-6294
(FAX) 319-235-0028

UNITED STATES PUBLIC LAND SURVEY CORNER CERTIFICATE


Land Survey Monuments situated in Section 32, Township 90N, Range 14W, of the Fifth Principal Meridian, BLACK HAWK County, Iowa.
Previously recorded in N/A in County Recorder's Office.
(book, page, document number, etc.)

(Show reason for preparing this certificate, the evidence and detailed procedures used in establishing the corner positions and monumentation found or placed.)

Monument Description and Remarks N¹/₄ COR. FOUND STD. MON. 12" DEEP 0.9'S. & 0.6'E
OF CORNER POST. SET 5/8" & STEEL FORM PIN ON EAST SIDE OF MONUMENT @ 1" BELOW
TP. ALSO, SET 3" SPIKE OVER TOP OF MONUMENT.

PLAN - VIEW

(Show a minimum of three reference ties to durable physical objects, relevant monuments and physical conditions that will enable recovery of the corner.)

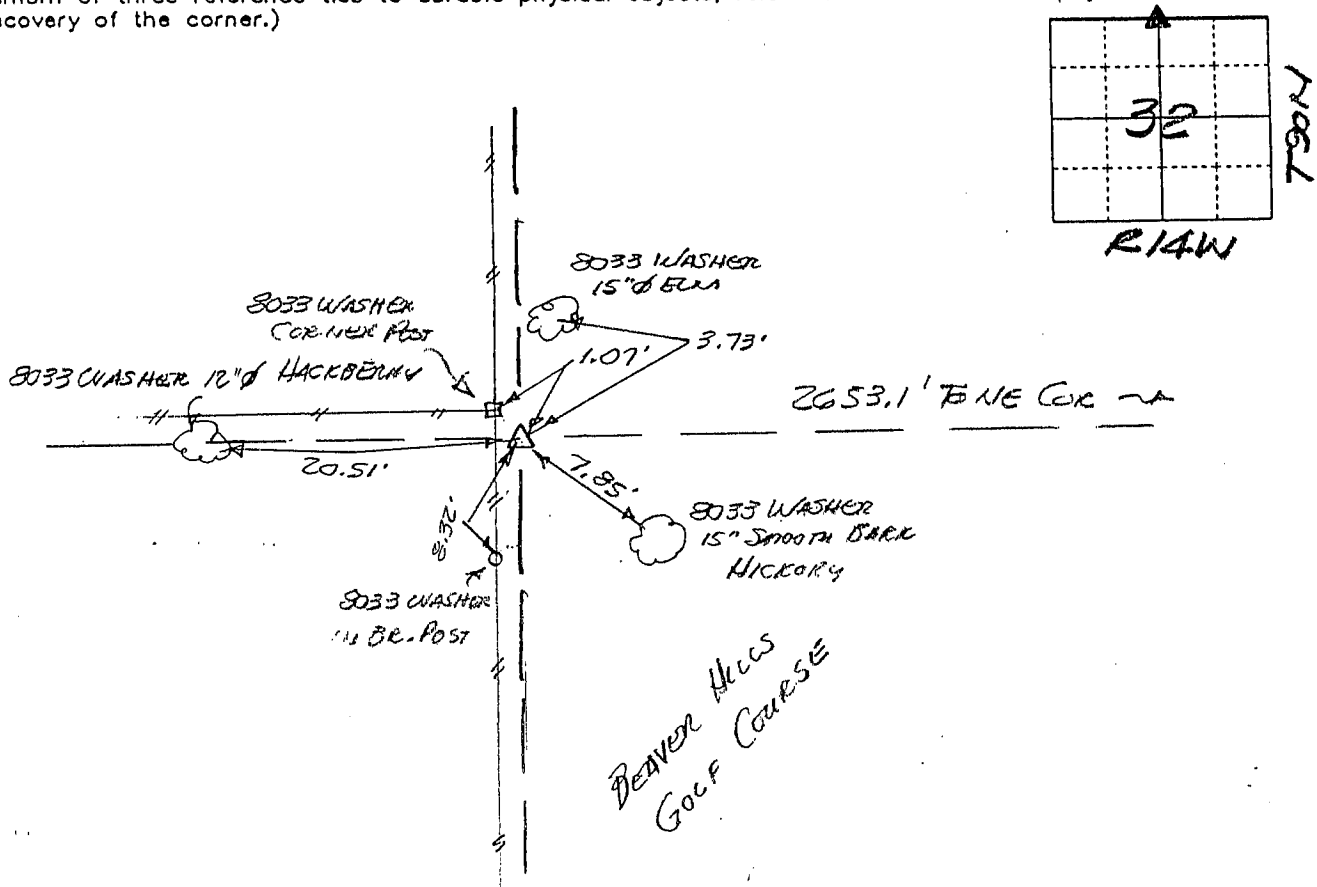

526-35

I hereby certify that the survey work was completed and this certificate was prepared by me or under my direct personal supervision and that I am a duly licensed land surveyor under the laws of the state of Iowa.


Signature: *F. William King*

(Name typed or printed:) F. WILLIAM KING

Date: 10-31-00

Lic. No. 8033

SEAL

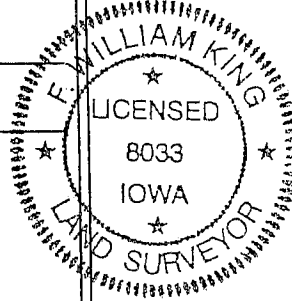

List Corners to be Indexed

Corners	Section	Twp	Range
<u>N¹/₄</u>	<u>32</u>	<u>90N</u>	<u>14W</u>

BOOK 0340 PAGE 831