

SC  
MISC  
INDEX  
MARGIN  
PROOF  
COMPARE

473  
BLACK HAWK COUNTY IOWA:SS  
FILED FOR RECORD JULY 6, 1999 AT  
4:00 P. M. AND RECORDED IN BOOK 334  
OF MISC PAGE 995.  
*Cynthia A. Liss* RECORDER  
FEE 1-5.00/  
CITY OF CEDAR FALLS

R. Allen Dietz, L.S. for the City of Cedar Falls  
217 Washington Street Cedar Falls, Iowa 50613 Ph. (319) 273-8606

# UNITED STATES PUBLIC LAND SURVEY CORNER CERTIFICATE OF


Land Survey Monuments situated in Section No. 35, Township No. T90N North, Range  
No. R14W West, of the Fifth Principal Meridian, Black Hawk County, Iowa.  
Previously recorded in Book \_\_\_\_\_ on Page \_\_\_\_\_ in the office of the County Recorder.  
(book, page, document number, etc.)

(Show reason for preparing this certificate, the evidence and detailed procedures used in establishing the corner positions and  
monumentation found or placed.)

Monument Description and Remarks: Found 60d spike in centerline of asphalt pavement.  
Reset P-K nail from reference ties after asphalt overlay.

## PLAN - VIEW

(Show a minimum of three reference ties to durable physical objects, relevant monuments and physical conditions that will enable  
recovery of the corner.)

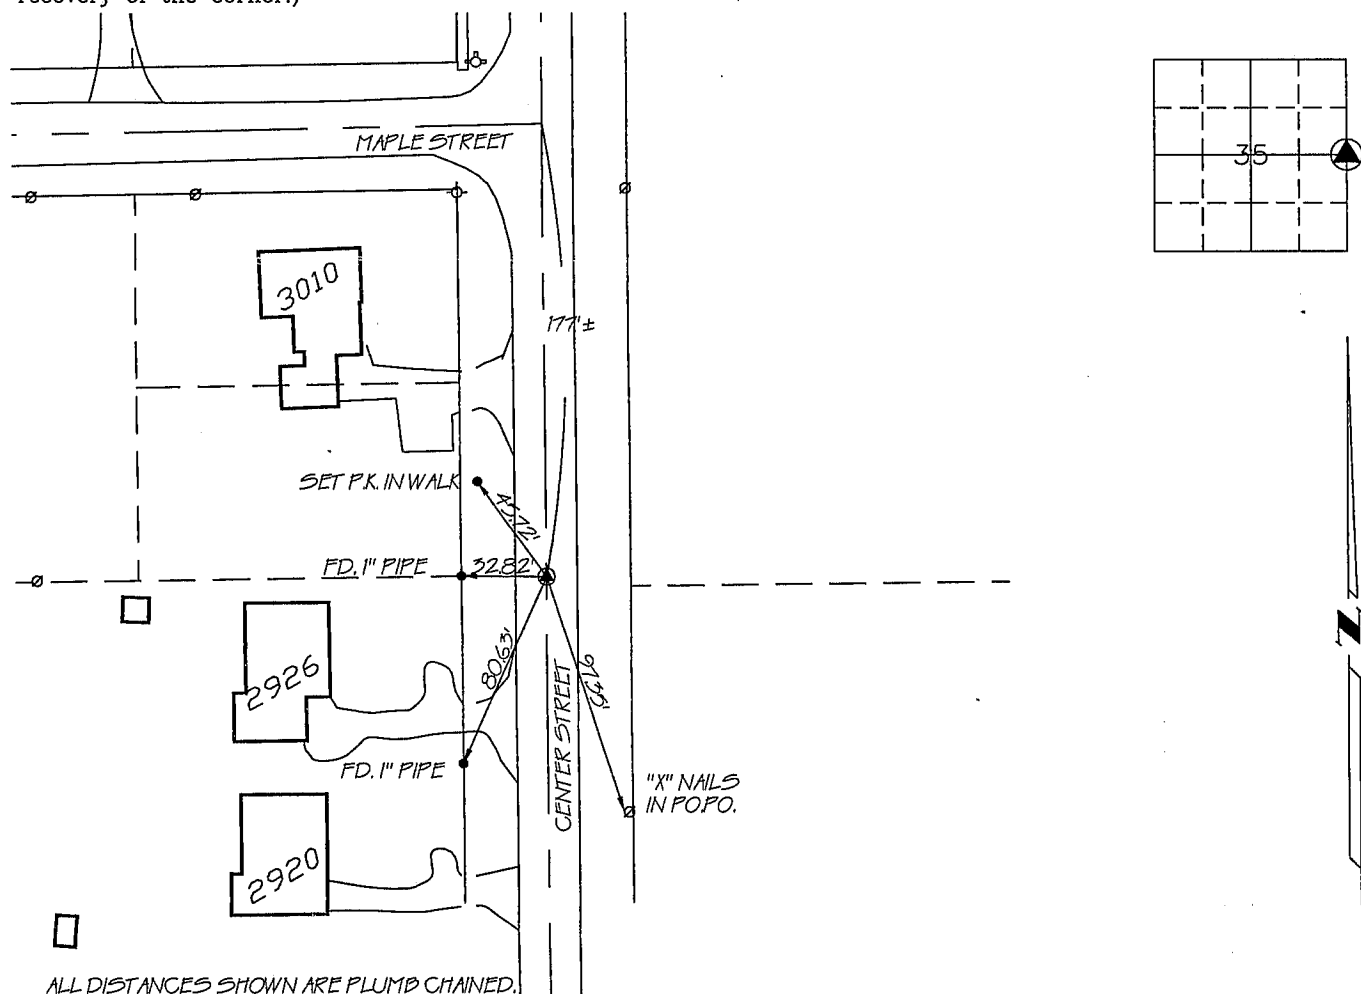


I hereby certify that this land surveying document was prepared  
by me or under my direct personal supervision and that I am  
a duly licensed Professional Land Surveyor under the laws of  
the State of Iowa.

Signed: *R. Allen Dietz*  
R. Allen Dietz, License No. 12086

Date: 1 July, 1999

SEAL

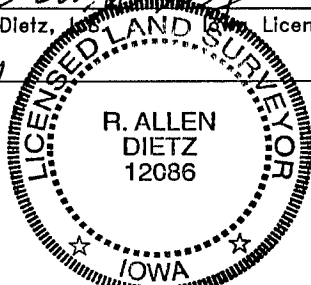

My License renewal date is December 31, 2000.  
Pages or sheets covered by this seal : this page only

Corners	List Corners to be Indexed Section	Twp	Range
E $\frac{1}{4}$	35	T90N	R14W

334 PAGE 995

Drawn by : RR

Checked by : RAD