

SC
MISC
INDEX
MARGIN
PROOF
COMPARE

BLACK HAWK COUNTY IOWA:SS
FILED FOR RECORD JULY 6, 1999 AT
4:00 P. M. AND RECORDED IN BOOK 335
OF MISC PAGE 001
Christie L. Lass RECORDER
FEE 1-5.00/
CITY OF CEDAR FALLS

478

R. Allen Dietz, L.S. for the City of Cedar Falls
217 Washington Street Cedar Falls, Iowa 50613 Ph. (319) 273-8606

UNITED STATES PUBLIC LAND SURVEY CORNER CERTIFICATE OF

Land Survey Monuments situated in Section No. 35, Township No. 90 North, Range
No. 14 West, of the Fifth Principal Meridian, Black Hawk County, Iowa.
Previously recorded in Book N/A on Page N/A in the office of the County Recorder.
(book, page, document number, etc.)


(Show reason for preparing this certificate, the evidence and detailed procedures used in establishing the corner positions and
monumentation found or placed.)

Monument Description and Remarks: Found iron pin in asphalt pavement.

Set "PK" nail in centerline of asphalt pavement from reference ties after
asphalt overlay.

PLAN - VIEW

(Show a minimum of three reference ties to durable physical objects, relevant monuments and physical conditions that will enable
recovery of the corner.)

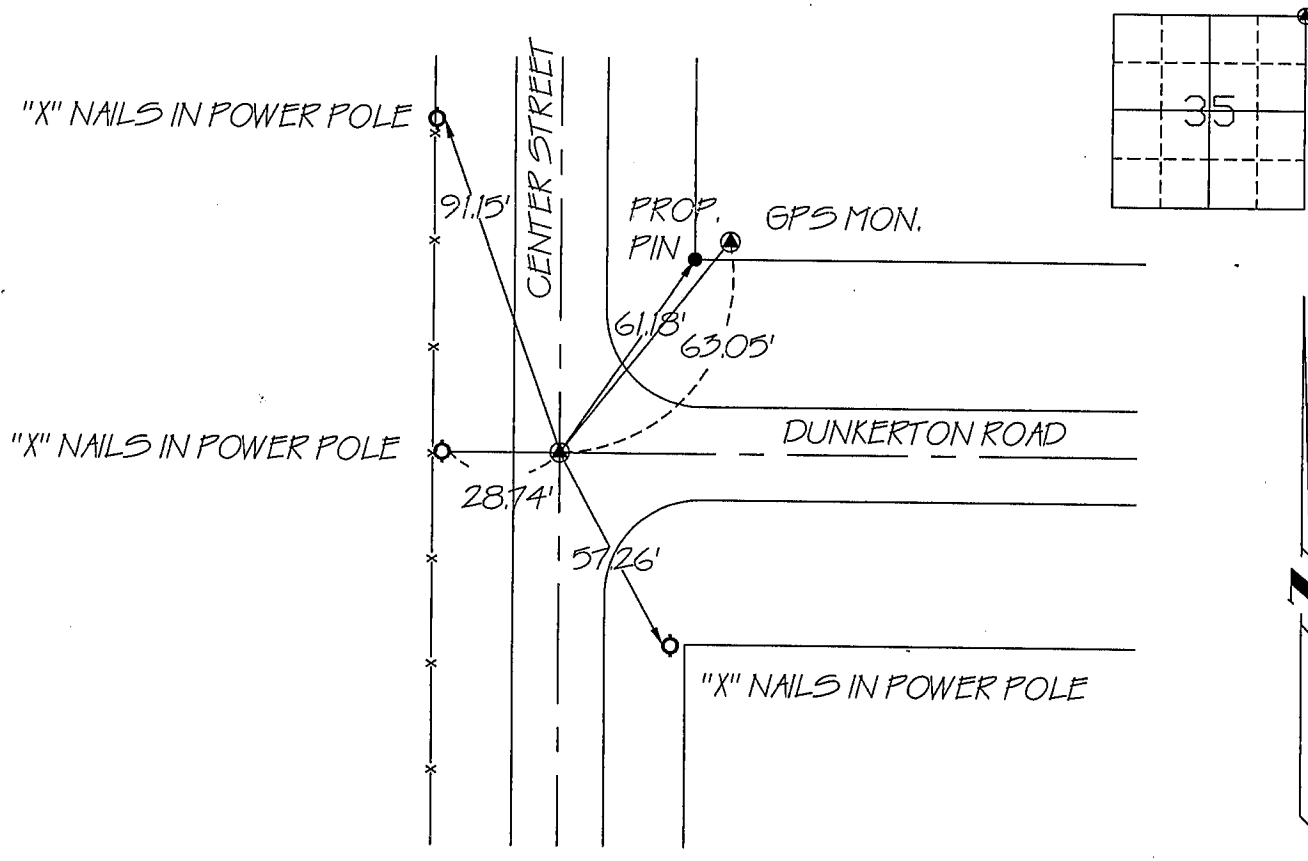


ALL DISTANCES SHOWN ARE SLOPED CHAINED.

I hereby certify that this land surveying document was prepared
by me or under my direct personal supervision and that I am
a duly licensed Professional Land Surveyor under the laws of
the State of Iowa.

Signed: *R. Allen Dietz*
R. Allen Dietz, Iowa License No. 12086

Date: *1 July* 1999

SEAL

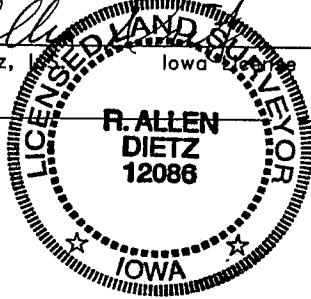

My License renewal date is December 31, 2000.
Pages or sheets covered by this seal : this page only

| Corners | List Corners to be Indexed Section | Twp | Range |
|---------|---------------------------------------|-----|-------|
| NE cor. | 35 | 90 | 14 |

335 PAGE 001

Drawn by : RR

Checked by : AD