

Kirk D. Eschliman, P.L.S. Iowa Lic. No. 9961, 723 Broadway Street, Waterloo, Iowa 50703 - Phone: 319-234-0509

# UNITED STATES PUBLIC LAND SURVEY CORNER CERTIFICATE OF

LAND SURVEY MONUMENTS SITUATED IN SECTION THIRTY-SIX (36), TOWNSHIP NINETY (90) NORTH  
RANGE FOURTEEN (14) WEST, OF THE FIFTH PRINCIPAL MERIDIAN, BLACK HAWK COUNTY, IOWA.  
PREVIOUSLY RECORDED IN DOC. NO. 2007014794 (BOOK, PAGE, DOCUMENT NUMBER, ETC.) IN THE COUNTY RECORDER'S OFFICE.


(SHOW REASON FOR PREPARING THIS CERTIFICATE, THE EVIDENCE AND DETAILED PROCEDURES USED IN ESTABLISHING THE CORNER POSITIONS AND MONUMENTATION FOUND OR PLACED.)

## MONUMENT DESCRIPTION AND REMARKS:

THIS SECTION CORNER CERTIFICATE IS BEING FILED AS A CORRECTION TO DOCUMENT NUMBER 2007014794.

SET NO. 4 REBAR WITH YELLOW ID. CAP "IOWA-9961." MONUMENT ESTABLISHED BASED ON SECTION

BREAKDOWN FOR REFERENCED FIELD SURVEY.

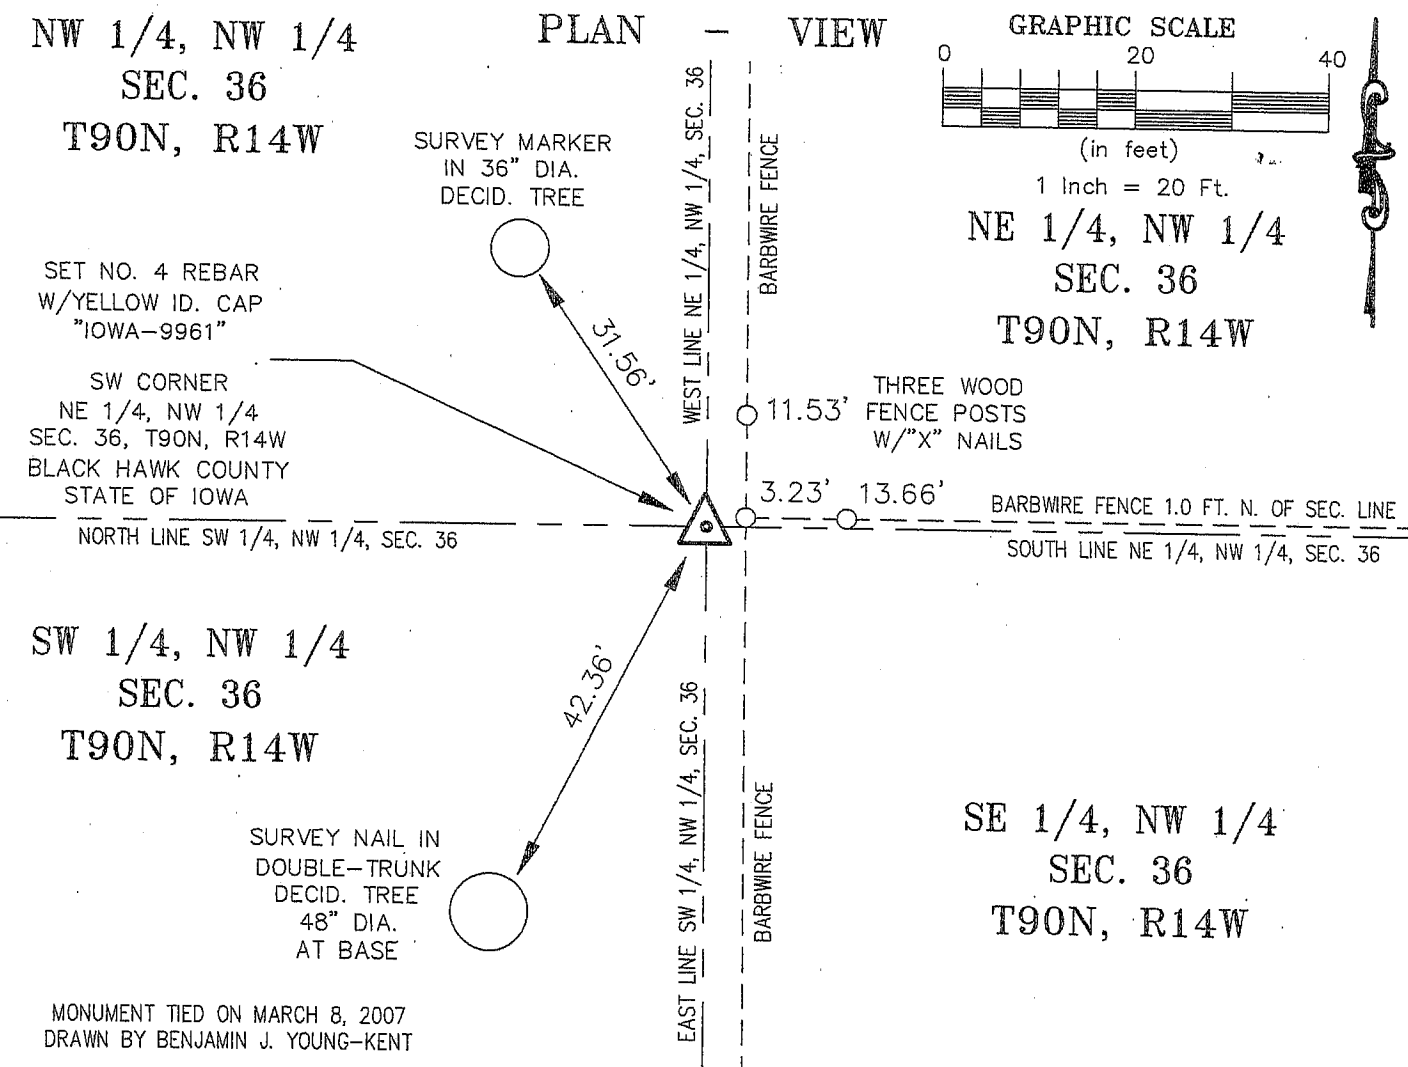

I HEREBY CERTIFY THAT THIS LAND SURVEYING DOCUMENT  
WAS PREPARED AND RELATED SURVEY WORK WAS  
PERFORMED BY ME OR UNDER MY DIRECT PERSONAL  
SUPERVISION AND THAT I AM A DULY LICENSED LAND  
SURVEYOR UNDER THE LAWS OF THE STATE OF IOWA.

*Kirk D. Eschliman* DATE: 03/18/2007  
KIRK D. ESCHLIMAN, P.L.S. IOWA LIC. NO. 9961  
MY LICENSE RENEWAL DATE IS DECEMBER 31, 2007  
PAGES OR SHEETS COVERED BY THIS SIGNATURE & SEAL: SHEET 1 OF 1

FOR: GUILLERMO F. NODARSE  
412 W. DUNKERTON ROAD  
CEDAR FALLS, IOWA 50613

REQ. BY: MARDY HOLST, AHTS ARCHITECTS  
WATERLOO, IOWA 50703




**KESS & ASSOCIATES, INC.**  
PROFESSIONAL LAND SURVEYORS : 723 BROADWAY, WATERLOO, IOWA 50703-581  
DATE: 03/18/2007 C.A.D.D. FILE: 06C28SCC1R.DWG PROJECT NO.: 06C28

## List of corners to be indexed:

Corner	Section	Township	Range
SW COR.	36	T90N	R14W
NE 1/4, NW 1/4			

R14W

T90N

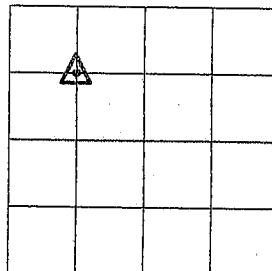

SECTION 36